

GEODETIC SURVEY OF N.S.W.

GENERAL MAPPING AUTHORITY

GEODETIC STATION RECONNAISSANCE and MAINTENANCE REPORT

Description: *Note: Cross out word or words which do not apply*

1. Cleared by lanes bearing..... from Trig. Mast

2. Mast & Vanes have been painted white & black respectively.

3. The station/pillar was unpiled/not unpiled/constructed on..... 19....., dimensions now being:

Description of mark..... should be ^{above} ~~below~~ ^{above} ~~below~~ G.L.

Height of mark..... m. ^{above} ~~below~~ rock/concrete; Mark is..... m. ^{above} ~~below~~ G.L.

Height of Top Vanes (o Top Mark/Pillar plate)..... m. Diameter of Vanes (vertical)..... m.

Height of Cairn..... m. Diameter of Cairn..... m. Name Plate found/not found/placed.

Length of Mast..... m. (approximate if not unpiled)

4. A..... **S.S.M.**..... set in conc/~~rock~~ has been ~~found~~ found, bearing..... °M from Mast/Plug/Pillar

5. A..... set in conc/rock has been placed/ found, bearing..... °M from Mast/Plug/Pillar

6. A..... set in conc/rock has been placed/ found, bearing..... °M from Mast/Plug/Pillar

7. A..... set in conc/rock has been placed/ found, bearing..... °M from Mast/Plug/Pillar

8. Action required:.....

Report

Trig set down cairn to 1/2 demerol level. All 3 trees to be cleared to clear hill 360°. Hill visible. Showing Colony Yellow Abundant made possibly top. Bulbs 65. Cairn. Other hills visible to the south. Close ridge to the west blocking view 200m to 300m and a lot higher than trig hill.

Prepared by:

[Signature] **Diwe**

C. 22/02/20


Noted on U.T.M. Chart

STATION: **OLD BUCK GS.** No.: **3616**

MAP SHEET SCALE 1:250 000

INSPECTED BY: **M.L. Morrison** DATE: **9/11/78**

AUTHORITY: **C.M.A.** FIELD BOOK: **1711**

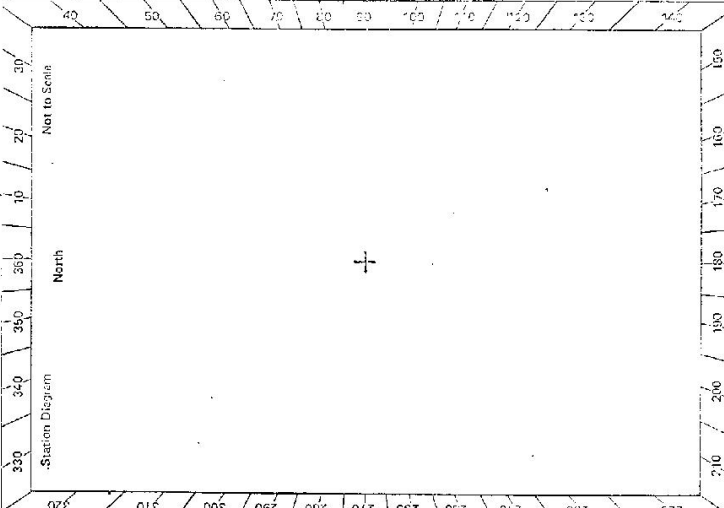


Checked

STATION: **OLD BUCK** No.: **3616**

MAP SHEET
SCALE 1:250 000 **WOLLONGONG**

INSPECTED BY: **G. KEEP** DATE: **10/8/81**

AUTHORITY: **C.M.A.** FIELD BOOK:

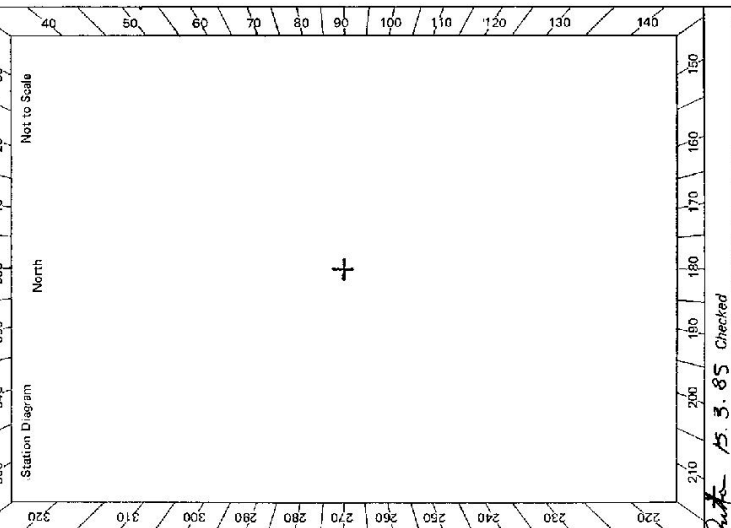

CENTRAL MAPPING AUTHORITY
GEODETIC SURVEY OF N.S.W.
GEODETIC STATION RECONNAISSANCE and MAINTENANCE REPORT


Description: *Note: Cross out word or words which do not apply*

1. Cleared by lanes bearing..... from Trig. Mast
2. Mast & Vanes have been painted white & black respectively.
3. The station/pillar was unpiled/not unpiled/constructed on..... 19....., dimensions now being: Description of mark..... should be explicit, e.g., S/Steel Pillar Plate, Steel plug, Brass plug, Bolt, G.I. Pipe
Height of mark.....m. above rock/concrete; Mark is.....m. above G.L.
Height of Top Vanes to Top Mark/Pillar plate.....m. Diameter of Vanes (vertical).....m.
Height of Cairn.....m. Diameter of Cairn.....m. Name Plate found/not found/placed.
Length of Mast.....m. (approximate if not unpiled)
4. A..... **55M**.....set in ~~conc~~/rock has been placed/found, bearing **217**.....°M ^{to} from Mast/Plug/Pillar @ **2.5m**
5. A.....set in conc/rock has been placed/found, bearing.....°M from Mast/Plug/Pillar
6. A.....set in conc/rock has been placed/found, bearing.....°M from Mast/Plug/Pillar
7. A.....set in conc/rock has been placed/found, bearing.....°M from Mast/Plug/Pillar
8. Action required: **Needs new mast & vanes, cairn needs rebuilding**

STANDPOINT:

Mark	Direction	Horiz. Distance	Height Difference	Mark	Direction	Horiz. Distance	Height Difference
			above standpt.				above standpt.
			below standpt.				below standpt.
			above standpt.				above standpt.
			below standpt.				below standpt.
Prepared by: **Goffrey Keep** 19/8/81
Checked: **G. Dute** 15.3.85
Noted on U.T.M. Card

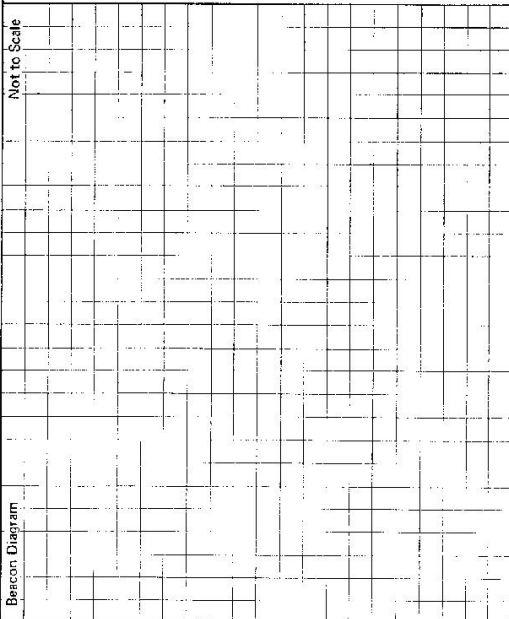ST 2733-2 D. West, Government Printer	STATION OLD BUCK IS 3616	<p>Owner's Name: Address: Phone:</p> <p>Current Occupant: Address: Phone:</p> <p style="text-align: center;"><u>ACCESS</u></p> <p>Access Report of D/S.1588 was found suitable/unsuitable.</p> <p style="text-align: center;"><i>Cairn only - which needs rebuilding, Mast & vanes destroyed. This trig, is on a bald hill and no clearing necessary</i></p>
Beacon Diagram	Not to Scale	
This section to be completed by officer constructing pillar.		
Original station mark found/not found.		
Description of mark:		
Original beacon found/not found.		
Description of beacon:		
Height Top of Vanes to Top Markm.		
Height of markm. above G.L. below		
Diameter of Vanesm. Height of Cairnm.		
Original Beacon has/has not been destroyed by me.		
Date	Record of Station	