




TS363

TS363 CMA 3-092

Locality : Wilcannia

LGA : Central Darling

STATION CMA 3 - 092

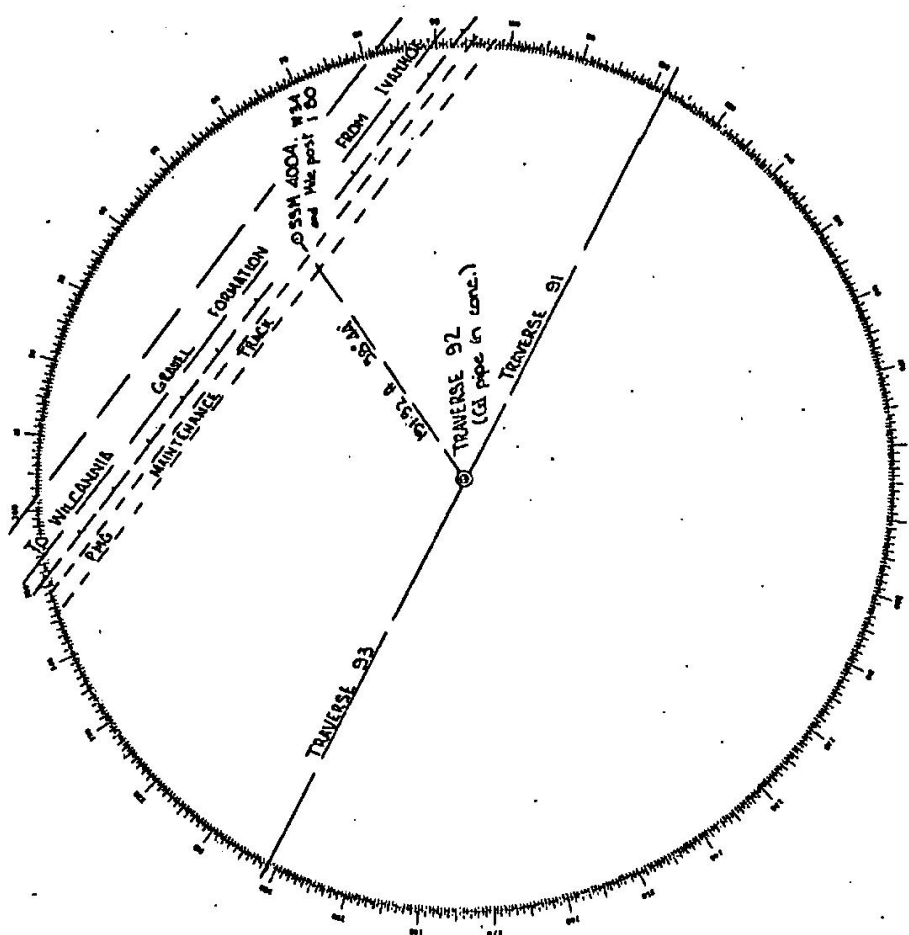

100% Identification