


TS  
P/3639

Department of Lands  
RECONNAISSANCE and MAINTENANCE REPORT: 625 STATION OVERTON  
Co: BRISBANE Ph: CLAWGARD  
Map Sheet: MUSWELLBROOK No: 9033  
Inspected by: A GRAHAM Date: 6.1.76  
Authority: I.S.D. NEWCASTLE Field Book: PDP188

Note: Cross out word or words which do not apply

This Trig. Station has been:-

1. Completely cleared to permit 360° vision to surrounding Trigs. ✓
2. Cleared by lanes bearing..... from Trig. Mast
3. Trig. Mast & Vanes have been painted white & black respectively. ✓
4. The Trig. was unpiled/~~re-erected~~, dimensions now being:  
Description of mark: concrete pillar should be explicit, e.g. Steel plug, Brass plug, Bolt, Concrete Pillar  
Height of mark: 0.0 m <sup>above</sup> rock-concrete pillar plate 1.26 m above G.L.  
Height of Top Vanes to ~~Top Mast~~ Top pillar plate 1.9 m Diameter of Vanes (vertical) 0.6 m.  
Height of Cairn 1.26 m. Diameter of Cairn..... m.  
Length of Mast 1.98 m. (approximate if not unpiled)
5. A. SSM set in conc/~~rock~~ has been placed/fd 3.116 m. bearing 16.0°M from Trig. ~~Mast~~/pillar
6. A. C.S set in conc/~~soil~~ has been placed/fd 5.95 m. bearing 71°M from Trig. ~~Mast~~/pillar
7. A..... set in conc/soil has been placed/fd..... m. bearing.....°M from Trig. Mast/pillar
8. A..... set in conc/rock has been placed/fd..... m. bearing.....°M from Trig. Mast/pillar
9. Connection SSM to C.S : 5.86 m. bearing 51°M
10. Connection..... to..... m. bearing.....°M
11. Connection..... to..... m. bearing.....°M
12. Connection..... to..... m. bearing.....°M
13. Diff. Ht. SSM is 1.307 m. <sup>above</sup> plate <sub>below</sub>
14. Diff. Ht. C.S is 1.685 m. <sup>above</sup> plate <sub>below</sub>
15. Diff. Ht. SSM is 0.375 m. <sup>above</sup> C.S
16. Diff. Ht. SSM is..... m. <sup>above</sup> below

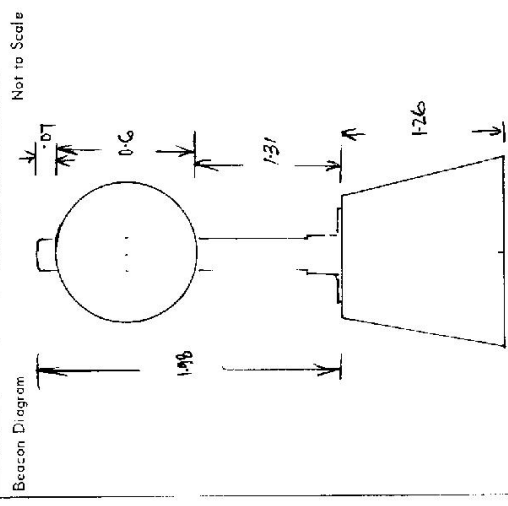

Date	Record of Station

Prepared by: AG Checked: A. Burrows

STATION OVERTON (P) IS 3639

Owners Name: ..... Current Occupant: .....


Address: ..... Address: .....

Access 6-1-1976

From Muswellbrook P.D. at 0.0 km via New England Highway towards Seane:

- 0.0 P.D.
- 1.4 Take Sandy Hollow Road on your left
- 2.1 Cross bridge over Hunter River
- 2.9 Take Sandy Hollow Rd on your left.
- 6.3 Take sealed Rd on Left Standst "BENGALLA"
- 7.2 Take left fork onto Gravel Rd thence treat to property "Overdene" on left. Follow fence beside Road through 2 gates turning right at 2nd Gate. Proceed along fence in East direction to 719 at 7.7 km.

"Access by 2 wheel drive"

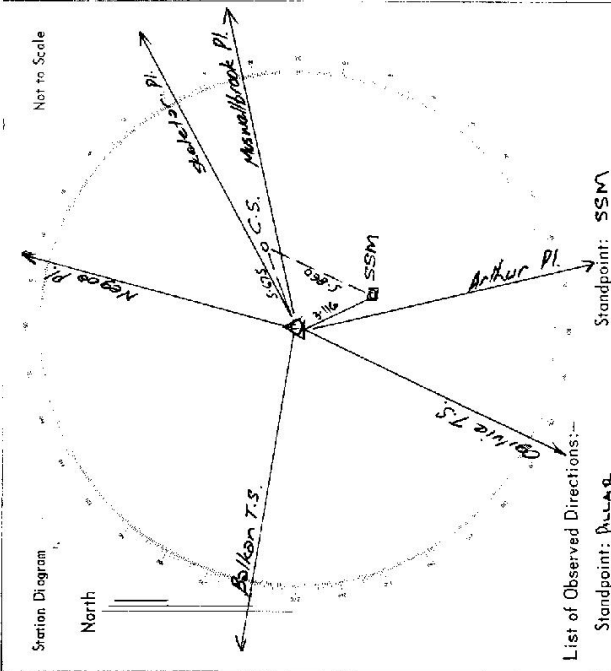

List of Observed Directions:-

Station	Direction	Station	Direction
Muswellbrook P.I.	0° 00' 00"	Muswellbrook P.I.	0° 00' 00"
SSM	71° 48' 24.5"	Bolkon T.S.	191° 28' 59"
Arthur P.I.	79° 52' 28.4"	Pillar (Overton)	251° 51' 23.5"
Opilue T.S.	114° 29' 34.7"	C.S.	322° 55' 23.5"
Bolkon T.S.	191° 26' 14.4"		

Station	Direction	Station	Direction
Negoa P.I.	208° 09' 42.1"		
Stake P.I.	348° 38' 05.2"		
C.S.	354° 11' 16.5"		

GEODETTIC SURVEY OF N.S.W.

CENTRAL MAPPING AUTHORITY

GEODETTIC STATION RECONNAISSANCE and MAINTENANCE REPORT

Description:

1. Cleared by lanes bearing.....  
 Note: Cross out word or words which do not apply  
 from Trig. Mast

2. Mast & Vanes have been painted white & black respectively.

3. The station/pillar was unpiled/hot unpiled/constructed on.....19....., dimensions now being:

Description of mark..... should be explicit, e.g., S/Steel Pillar Plate, Steel plug, Brass plug, Bolt, G.I. Pipe

Height of mark.....m..... above below rock/concrete; Mark is.....m..... above below G.I.L.

Height of Top Vanes to Top Mark/Pillar plate.....m..... Diameter of Vanes (vertical).....m.....

Height of Cairn.....m..... Diameter of Cairn.....m..... Name Plate found/not found/placed.

Length of Mast.....m..... (approximate if not unpiled)

4. A.....set in conc/rock has been placed/found, bearing.....°M from Mast/Plug/Pillar

5. A.....set in conc/rock has been placed/found, bearing.....°M from Mast/Plug/Pillar

6. A.....set in conc/rock has been placed/found, bearing.....°M from Mast/Plug/Pillar

7. A.....set in conc/rock has been placed/found, bearing.....°M from Mast/Plug/Pillar

8. Action required:.....

STANDPOINT:

STANDPOINT:

Mark	Direction	Horiz. Distance	Height Difference	Mark	Direction	Horiz. Distance	Height Difference
			above standpt				above standpt
			below standpt				below standpt
			above standpt				above standpt
			below standpt				below standpt
Prepared by:

Checked:

Checked

S.O. 1407

STATION: **OVERTON** No.: **3639**

MAP SHEETS SCALE 1:250 000 **Muswellbrook** SCALE 1:100 000

INSPECTED BY: **M CLARK** DATE: **20/8/87**

AUTHORITY: **CMA** FIELD BOOK:

Station Diagram

North

Not to Scale

GS 24

STATION **OVERTON TS 3639**


Owner's Name **Mr. I. Markham**  
 Address **13-15 Scot St  
 Muswellbrook**  
 Phone .....

Current Occupant:  
 Address .....

ACCESS  
 Access Report of **22/8/1987** was found suitable/unusable.

- 0.0 Muswellbrook PO via New England Hwy towards Scone.
- 1.4 turn LEFT onto Sandy Hollow road.
- 2.1 Cross bridge over Hunter River.
- 2.9 Turn LEFT onto Sandy Hollow road.
- 6.3 Turn LEFT onto sealed road.
- 6.8 Pass hayshed on LHS.
- 6.9 T rn LEFT thru iron gate,hrad straight across paddock.
- 7.1 Stop at fence,OVERTON GS

TWO WHEEL DRIVE ACCESS

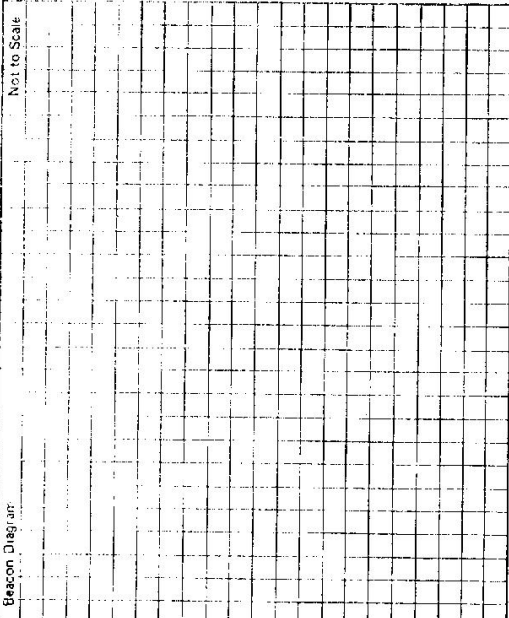

This section to be completed by officer constructing pillar.

Original station mark found/not found.

Description of mark: .....

Original beacon found/not found.

Description of beacon: .....

Height Top of Vanes to Top Mark.....m.

Height of mark.....m. above rock/conc.....ft. below G.L.

Diameter of Vanes.....m. Height of Cairn.....m.

Original Beacon has/has not been destroyed by me.

Date	Record of Station

**TS 3639**

ACCESS FOR TS OVERTON (P)

Date : 17/1/95 By J Cassidy

Distance Feature

0.00 Kms	Muswellbrook P.O. head towards Scone
1.45	Turn Left onto Sandy Hollow - Merriwa Rd
2.95	Turn Left onto Wybong Rd
6.05	Turn Left onto Bengalla Rd
6.55	Turn Left into "Rainbow Farms" trotting farm.
6.6	Turn Right before crush follow track South.
6.85	Turn left onto trotting track
6.95	Trig