

CENTRAL MAPPING AUTHORITY
Department of Lands

Topographical Survey of N.S.W.

RECONNAISSANCE and MAINTENANCE REPORT

This Trig. Station has been:

Note: Cross out word or words which do not apply

1. ~~Completely cleared to permit 360° vision to surrounding Trig.~~
2. Cleared by lones bearing..... from Trig. Mast
3. ~~Trig. Mast & Vanes have been painted white & black respectively.~~
4. The Trig. was ~~unpiled~~/not unpiled, dimensions now being:
 - Description of mark..... should be explicit, e.g. Steel plug, Brass plug, Bolt, G.I. Pipe
 - Height of mark..... m ^{above} / _{below} rock/concrete..... m ^{above} / _{below} G.I.
 - Height of Top Vanes to Top Mark..... m. Diameter of Vanes (vertical)..... m.
 - Height of Cairn..... m. ^{0.55} / _{0.75} m.
 - Length of Mast..... m. (approximate if not unpiled)

5. A..... set in conc/rock has been placed..... m. bearing.....°M from Trig. Mast
6. A..... set in conc/soil has been placed..... m. bearing.....°M from Trig. Mast
7. A..... set in conc/soil has been placed..... m. bearing.....°M from Trig. Mast
8. A..... set in conc/rock has been placed..... m. bearing.....°M from Trig. Mast
9. Connection..... to..... m. bearing.....°M
10. Connection..... to..... m. bearing.....°M
11. Connection..... to..... m. bearing.....°M
12. Connection..... to..... m. bearing.....°M
13. Diff. Ht. is..... m. ^{above} / _{below}.....
14. Diff. Ht. is..... m. ^{above} / _{below}.....
15. Diff. Ht. is..... m. ^{above} / _{below}.....
16. Diff. Ht. is..... m. ^{above} / _{below}.....

Prepared by: M.L. Morrison Checked: _____ Noted on U.T.M. Card

STATION PADDYS HILL TS 3647


Co: VERNON | Pt: KANGAROO FLAT

Map Sheet: COWARRAL | No: 9335

Inspected by: M.L. Morrison | Date: 16th August 1977

Authority: _____ | Field Book: 1581

Beacon Diagram: _____ | Not to Scale

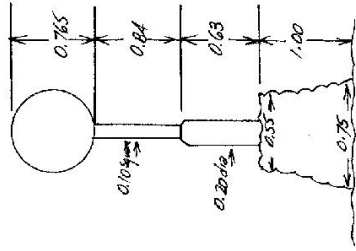

Date

Record of Station

*TRIG PD IN GOOD ORDER NEEDS PAINTING
850714 BOLT AT BOTTOM IN CONC IS
HILLOCKY BRUSH TO LONE (TRUCK IS A COMP FOR SLOPE
AND (BATTLE) BUT VERY LOOSE/EASY TO LONE) REQUIRED.*

Checked

