


7400

Trigonometrical Survey of N.S.W.  
 RECONNAISSANCE and MAINTENANCE REPORT

Department of Lands  
 STATION PARAA T.S. 3650  
 Co: DAVIE Ph: P. 248221  
 Map Sheet: DMND150 No: 51400.5  
 Inspected by: Dale J. Hall Date: 21 May 1975  
 Authority: C.M.A. 7273 Field Book: 01381

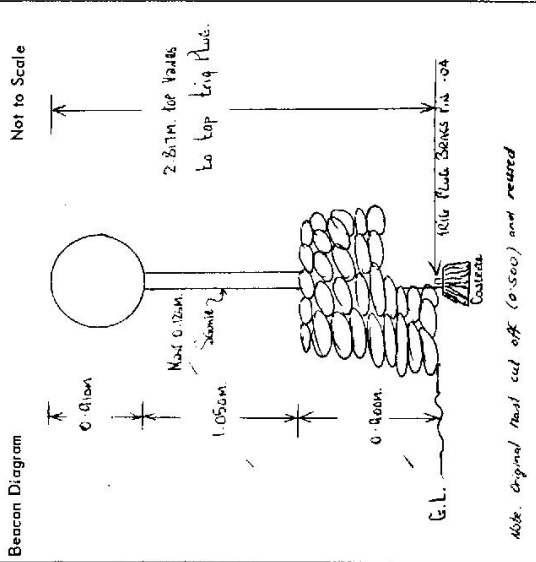

This Trig. Station has been: ✓ Note: Cross out word or words which do not apply

1. Completely cleared to permit 360° vision to surrounding Trigs. ✓
2. Cleared by lanes bearing to from Trig. Mast
3. Trig. Mast & Vanes have been painted white & black respectively. ✓
4. The Trig. was unpainted/~~repainted~~, dimensions now being:

Description of mark: Brass plug should be explicit, e.g. Steel plug, Brass plug, Bolt, G.I. Pipe  
 Height of mark: 0.043m above concrete M above G.I.  
 Height of Top Vanes to Top Mark: 2.87 m. Diameter of Vanes (vertical) 0.10m  
 Height of Cairn: 0.000m / Diameter of Cairn: 2.200m m. ✓

- Length of Mast: 2.87 m. (approximate if not unpainted)  
 5. Cu. nail set in conc./~~soil~~ has been placed 2.150 m. bearing 312° M from Trig. Mast  
 6. A.I.P. set in conc./~~soil~~ has been placed 2.410 m. bearing 193° M from Trig. Mast  
 7. A set in conc./soil has been placed      m. bearing      M from Trig. Mast  
 8. A set in conc./rock has been placed      m. bearing      M from Trig. Mast

9. Connection wood to brick: 5.615 m. bearing 161° M  
 10. Connection to:      m. bearing      M  
 11. Connection to:      m. bearing      M  
 12. Connection to:      m. bearing      M  
 13. Diff. Ht. TRIG. PLUG is 0.385 m. above Cu. nail in conc.  
 14. Diff. Ht. TRIG. PLUG is 0.100 m. above G.I.P. in conc.  
 15. Diff. Ht. Cu. nail in conc. is 0.285 m. above G.I.P. in conc.  
 16. Diff. Ht.      is      m. above

| Date           | Record of Station  |
|----------------|--|
| <u>30/4/73</u> | <u>Mast Vanes set Top Mark to top Trig. Plug 2.877 + 0.500 = 3.377</u>     |
| <u>2/7/75</u>  | <u>G.I.P. placed in soil</u>   |
|                | <u>TRIG. Plug in soil found replaced in conc. Mast shortened by 0.500m</u> |

Prepared by: D.W. FREDRIKSEN Checked: P.R. Bannock Noted on U.T.M. Card  
 4


STATION PAGAN T.S. 3650

Owners Name.....  
 Current Occupant.....  
 Address.....  
 Address.....  
 Access.....

Not to Scale

Station Diagram

North

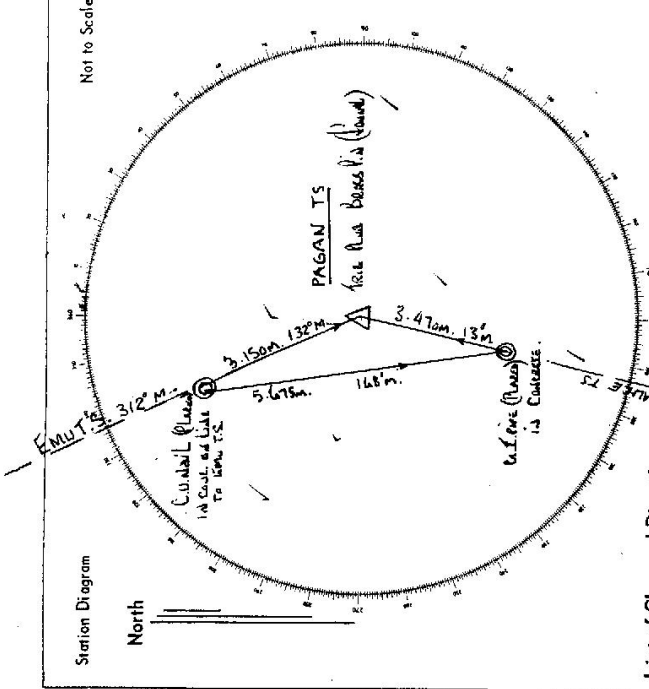

List of Observed Directions:-

| Station  | Direction | Station         | Direction |
|--|-----------|-----------------|-----------|
| EMU T.S.   | 359.59.60 | EMU T.S.        | 359.59.60 |
| Copper nail in conc.                                       | 0° 00'    | G.I.P. in conc. | 232.47.00 |
| G.I.P. in conc.  | 232.14    | TRIG. PILLAR    | 179.59    |
| Standpoint: TRIG. PILLAR. Standpoint: Copper nail in conc. |           |                 |           |
| Station  | Direction | Station         | Direction |
| EMU T.S.   | 359.59.60 |                 |           |
| Copper nail in conc.                                       | 32.47.00  |                 |           |
| TRIG. PILLAR   | 62.11     |                 |           |
| Standpoint: G.I.P. in conc.                                |           |                 |           |
| Station  | Direction | Station         | Direction |
| EMU T.S.   | 359.59.60 |                 |           |
| Copper nail in conc.                                       | 32.47.00  |                 |           |
| TRIG. PILLAR   | 62.11     |                 |           |

67