

CENTRAL MAPPING AUTHORITY

GEODETIC SURVEY OF NSW

GEODETIC STATION RECONNAISSANCE and MAINTENANCE REPORT


STATION: PALERANG No.: 3652

MAP SHEET SCALE 1:250 000 CANBERRA

INSPECTED BY: G. C. HANNA DATE: 3/5/79

AUTHORITY: C. M. A. FIELD BOOK:

- Description:
- Note: Cross out word or words which do not apply*
1. Cleared by lances bearing..... from Trig. Mast
 2. Mast & Vanes have been painted white & black respectively.
 3. The station/pillar was unpiled/not unpiled/constructed on..... 19..... dimensions new being:
Description of mark..... should be explicit, e.g., S/Steel Pillar Plate/Steel plug/Brass plug, Bolt, G.I. Pipe
Height of mark.....m. ^{above} rock/concrete; Mark is.....m. ^{above} G.L.
 4. A..... set in conc./rock has been placed/found, bearing.....° M from Mast/Plug/Pillar
 5. A..... set in conc./rock has been placed/found, bearing.....° M from Mast/Plug/Pillar
 6. A..... set in conc./rock has been placed/found, bearing.....° M from Mast/Plug/Pillar
 7. A..... set in conc./rock has been placed/found, bearing.....° M from Mast/Plug/Pillar
 8. Action required:.....

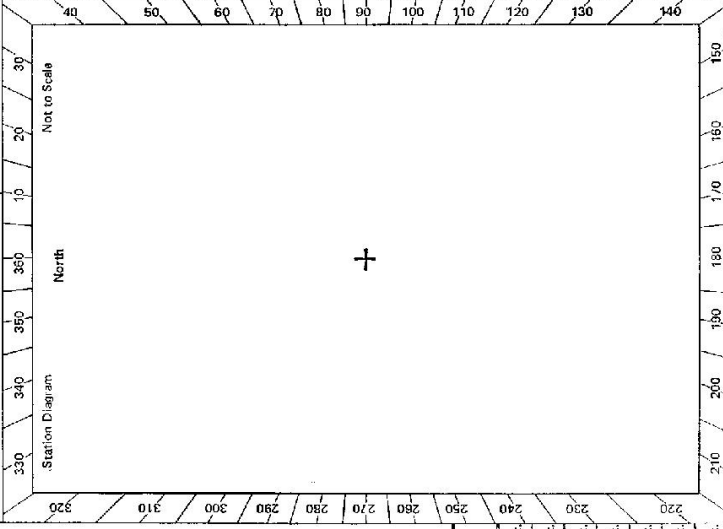


STANDPOINT:

Mark	Direction	Horiz. Distance	Height Difference	Mark	Direction	Horiz. Distance	Height Difference
			above standpt. below				above standpt. below
			above standpt. below				above standpt. below
Prepared by: *G. Hanna* 3/5/79 Checked: *[Signature]*

SI 2733-2 D. West, Government Printer

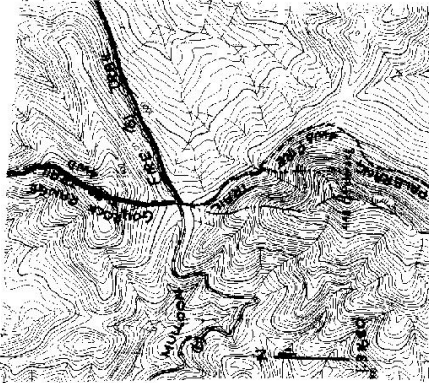STATION PALERANG TS 3652	Owner's Name: Address: Phone: Current Occupant: Address: Phone:	ACCESS Access Report of 3.5.77 was found suitable/unsuitable.	ACCESS * Braidwood to Bombay Bridge on Hoskinstown Rd. * 450 m from Bridge turn Right at Little Bombay Sp * Follow road & take left fork at approx 4km * 7.5 km approx take left fork (main road). * 13 km approx turn left onto Palerang Fire Trail. * 13-7 km park truck, take best course to trig.	Cairn, mast & vanes found 45 minute walk up steep slope Light clearing required For further information see Bombay 8827-III-S	
Beacon Diagram Not to Scale	This section to be completed by officer constructing pillar. Original station mark found/not found. Description of mark: Original beacon found/not found. Description of beacon: Height Top of Vanes to Top Markm. Height of markm. above rock/concm. above G.L. belowm. below G.L. Diameter of Vanesm. Height of Cairnm. Original Beacon has/has not been destroyed by me.				
				Date Record of Station	