

CENTRAL MAPPING AUTHORITY
Department of Lands

Trigonometrical Survey of N.S.W.

RECONNAISSANCE and MAINTENANCE REPORT

This Trig. Station has been:-

Note: Cross out word or words which do not apply


1. Completely cleared to permit 360° vision to surrounding Trig.
2. Cleared by limes bearing from Trig. Mast
3. Trig. Mast & Vanes have been painted white & black respectively.
4. The Trig. was unpiled/~~not supplied~~, dimensions now being:
Description of mark Plug found should be explicit, e.g. Steel plug, Brass plug, Bolt, G.L. Pipe
Height of mark m ^{above} / _{below} rock/concrete m ^{above} / _{below} G.L.
Height of Top Vanes to Top Mark 1.58 m. Diameter of Vanes (vertical) 0.48 m.
Height of Cairn 1.0 m. Diameter of Cairn 2 m.
Length of Mast 3.30 m. (approximate if not unpiled)

5. A set in conc/rock has been placed m. bearing °M from Trig. Mast
6. A G.I. Pipe set in ~~conc~~/soil has been placed 3.64 m. bearing 310 °M from Trig. Mast
7. A set in conc/soil has been placed m. bearing °M from Trig. Mast
8. A set in conc/rock has been placed m. bearing °M from Trig. Mast
9. Connection to m. bearing °M
10. Connection to m. bearing °M
11. Connection to m. bearing °M
12. Connection by m. bearing °M
13. Diff. Ht. Pipe in Soil is 5.43 m. ^{above} / _{below} Trig. Plug
14. Diff. Ht. is m. ^{above} / _{below}
15. Diff. Ht. is m. ^{above} / _{below}
16. Diff. Ht. is m. ^{above} / _{below}

Prepared by: PH Mill

Checked: Alan Woodroffe Noted on U.T.M. Card

STATION PARADISE GS 3665
Ph:
Map Sheet: JACOBS RIVER No: 8524
Inspected by: R LANDER Date: 8.2.77
Authority: CMR Field Book: 1536
Beacon Diagram: 1529
Not to Scale

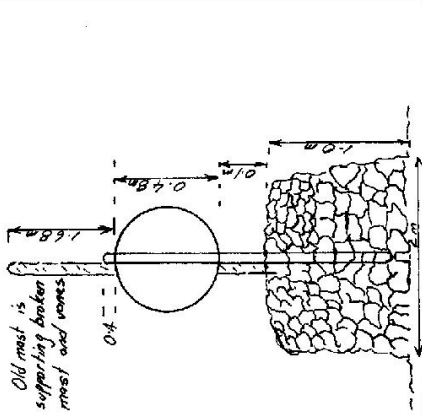


Date:
Record of Station: The cairn was unpiled and the plug found.
Checked: Alan Woodroffe

STATION PARADISE G.S. TS 3665

Owners Name:
 Current Occupant:
 Address: KASSEUSAO, MATAMORA,
 Park:

Access 8-2-1977
 It is essential to have the Jacobs River 1:100000 Map
 At Theobro go towards Khorocoban
 At about 4km from Theobro at Dead Horse Gap
 take a left hand turn through car park onto
 fire trail. (need key from Ranger)
 Travel along this trail for 6km until you
 reach Casseada Mt on left. Go down post
 hut (through fence) and down towards creek.
 Leave vehicle here. Walk up creek for
 about 4km. Turn to the left up creek and walk to
 the bottom of Paradise Hill so that the tree line across
 the saddle between Paradise and Purgatory Hills is
 intercepted. Follow scrub covered creek to top of
 hill and trig. N.B. A Contoured map is essential to take

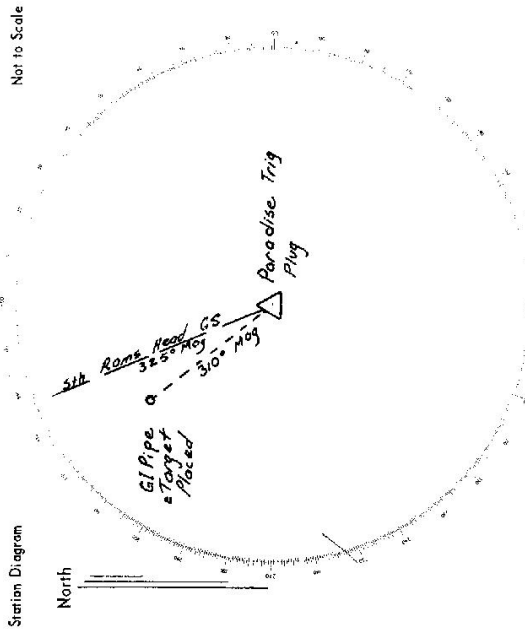

List of Observed Directions:-

Standpoint: Trig Plug		Station	Direction
Station	Direction	Station	Direction
5th Rams Head	0 00 00		
GI Pipe a Target Placed	351 25 39		
Station	Direction	Station	Direction