

GEODETIC SURVEY OF N.S.W.

CENTRAL MAPPING AUTHORITY

GEODETIC STATION RECONNAISSANCE and MAINTENANCE REPORT

STATION: PARKES	No.: 3667
MAP SHEET SCALE 1:250 000	PARKES 1:50 000
INSPECTED BY: C. ZAHRA	DATE: 21.9.09
AUTHORITY: LIC	FIELD BOOK: -

Description:

1. Cleared by lanes bearing **340°-40° B. 150° - 230°** & narrow lanes of **70°** from Trig. Mast
small shed obstructs view to north

2. Mast & Vanes have been painted white & black respectively.

3. The station/pillar was unpiled/not unpiled/constructed on **19** m, dimensions now being: **found in remnants of cairn**
Description of mark: **Metal Plug** should be explicit, e.g., S/Steel Pillar Plate, Steel plug, Brass plug, Bolt, G.I. Pipe
Height of mark: **above** rock/concrete; Mark is **above** G.L.
Height of Top Vanes to Top Mark/Pillar plate: **No mast & vanes** Diameter of Vanes (vertical): **0** m.
Height of Cairn: **0** m. Diameter of Cairn: **0** m. Name Plate found/not found/placed.
Length of Mast: **0** m. (approximate if not unpiled)

4. A. **SSM** set in **conc/rock** has been **placed**/found, bearing **210** °M from **Mast/Plug/Pillar** at **4.94** m

5. A. set in **conc/rock** has been **placed**/found, bearing **0** °M from **Mast/Plug/Pillar**


6. A. set in **conc/rock** has been **placed**/found, bearing **0** °M from **Mast/Plug/Pillar**

7. A. set in **conc/rock** has been **placed**/found, bearing **0** °M from **Mast/Plug/Pillar**

8. Action required: **Note: No clearing allowed by owner**
NO ACTION REQUIRED FOR GEOD. SURVEYS

STANDPOINT:

Mark	Direction	Horiz. Distance	Height Difference	Mark	Direction	Horiz. Distance	Height Difference
			above standpt.				above standpt.
			below standpt.				below standpt.
			above standpt.				above standpt.
			below standpt.				below standpt.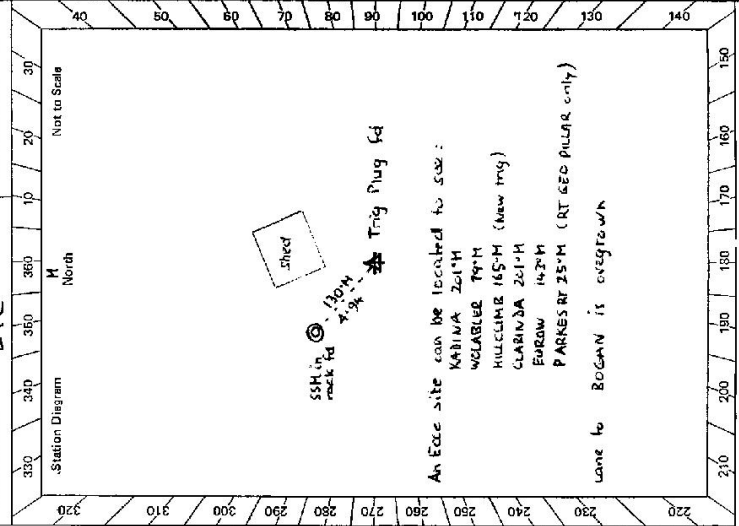
Prepared by: **C Zahra** Checked: **Noted on U.T.M. Card**

