

GEODETTIC SURVEY OF NSUK

CENTRAL MAPPING AUTHORITY

GEODETTIC STATION RECONNAISSANCE and MAINTENANCE REPORT

Description:

1. Cleared by lanes bearing.....  
 Note: Cross out word or words which do not apply from Trig. Mast.

2. Mast & Vanes have been painted white & black respectively.

3. The station/pillar was unpiled/not unpiled/constructed on.....19....., dimensions now being:

Description of mark.....should be explicit, e.g., S/Steel Pillar Plate, Steel plug, Brass plug, Bolt, G.I. Pipe

Height of mark.....m. <sup>above</sup> <sub>below</sub> rock/concrete; Mark is.....m. <sup>above</sup> <sub>below</sub> G.L.

Height of Top Vanes to Top Mark/Pillar plate.....m. Diameter of Vanes (vertical).....m.

Height of Cairn.....m. Diameter of Cairn.....m. Name Plate found/not found/placed.

Length of Mast.....m. (approximate if not unpiled)

4. A.....set in conc/rock has been placed/found, bearing.....°M from Mast/Plug/Pillar

5. A.....set in conc/rock has been placed/found, bearing.....°M from Mast/Plug/Pillar

6. A.....set in conc/rock has been placed/found, bearing.....°M from Mast/Plug/Pillar

7. A.....set in conc/rock has been placed/found, bearing.....°M from Mast/Plug/Pillar

8. Action required:.....

STANDPOINT:

Mark	Direction	Horiz. Distance	Height Difference	Mark	Direction	Horiz. Distance	Height Difference
			above below standpt				above below standpt
			above below standpt				above below standpt
Prepared by: *A. Hume*

Checked: *A. Hume*

S: 2733-1

Noted on U.T.M. Card

STATION: PEAK HILL No.: **TS 3687**

MAP SHEET SCALE 1:250 000 NARECHMINJE

INSPECTED BY: G. C. HANNA DATE: 2/10/78

AUTHORITY: C.M.A. FIELD BOOK:



CENTRAL MAPPING AUTHORITY

GEODETIC SURVEY OF N.S.W.

GEODETIC STATION RECONNAISSANCE and MAINTENANCE REPORT

Description:

- Cleared by lanes bearing  $55^{\circ} 16' 00''$   $276^{\circ} 30' 5''$  from Trig. Mast  
*Note: Cross out word or words which do not apply*
- Mast & Vanes have been painted white & black respectively.
- The station ~~marker~~ was unpiled/~~re-erected~~/~~constructed~~ on  $4 \times 2 \times 19$   $83$  dimensions now being:  
Description of mark: Bronze Pin should be explicit, e.g. S/Steel Pillar/Plate, Steel plug, Brass plug, Bolt, G.I. Pipe
- Height of mark  $0.45$  m. <sup>above</sup> rock/~~concrete~~; Mark is AT <sup>above</sup> G.L.
- Height of Top Vanes to Top Mark/~~Plate~~  $3.655$  m. Diameter of Vanes (vertical)  $1$  m.
- Height of Cairn  $0.80$  m. Diameter of Cairn  $1.4$  m. Name Plate ~~found~~/~~not found~~/~~placed~~.
- Length of Mast  $3.7$  m. (~~approximate if not computerized~~)
- A. S.S.M. set in conc/~~rock~~ has been ~~placed~~/~~found~~, bearing  $283^{\circ} 0'$  M from ~~Mast/Plug/Pillar~~
- A. G.I. Pipe set in conc/~~rock~~ has been ~~placed~~/~~found~~, bearing  $15^{\circ} 5'$  M from Mast/Plug/Pillar
- A. S.S.M. set in conc/~~rock~~ has been ~~placed~~/~~found~~, bearing  $0^{\circ} 0'$  M from Mast/Plug/Pillar
- A. S.S.M. set in conc/~~rock~~ has been ~~placed~~/~~found~~, bearing  $0^{\circ} 0'$  M from Mast/Plug/Pillar
- Action required: Place Station Name Plate


STANDPOINT:		STATION:		S. S. M	
Mark	Direction	Horiz. Distance	Height Difference	Mark	Direction
Caloma Conc. (P)	$0^{\circ} 00' 00''$		above standpt.	Caloma Conc. (P)	$0^{\circ} 00' 00''$
S.S.M.	$227^{\circ} 15' 37''$	$3.320$	above standpt.	Bronze In. Pin	$47^{\circ} 14' 54''$
G.I. Pipe	$317^{\circ} 42' 06''$	$2.763$	above standpt.	G.I. Pipe	$7^{\circ} 46' 16''$
			below standpt.		
			above standpt.		
			below standpt.		
			above standpt.		
			below standpt.		

Prepared by: D. Kain

Checked:

Noted on U.T.M. Card

S:2733-1

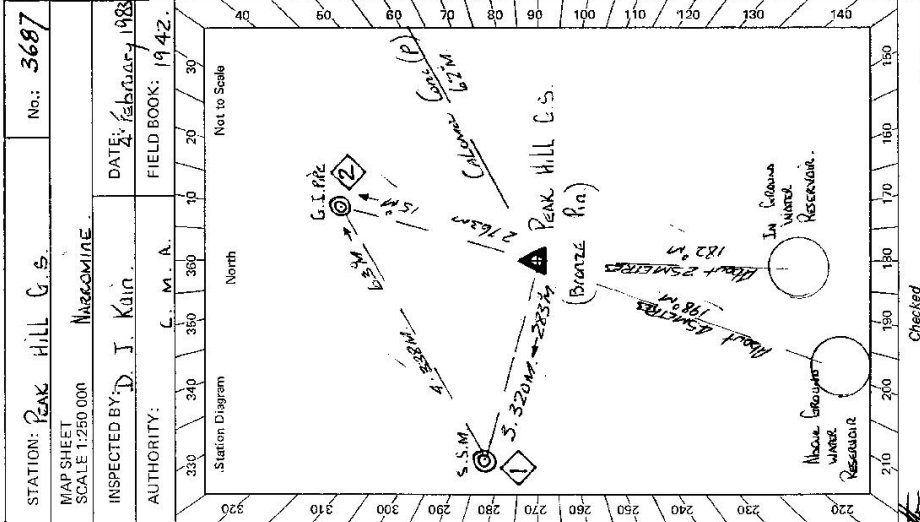

Checked

STATION: Peak Hill G.S. No.: 3687

MAP SHEET SCALE 1:250 000 MARGOMINE

INSPECTED BY: D. J. Kain DATE: 2 February 1983

AUTHORITY: C. M. A. FIELD BOOK: 1942

Station Diagram North

Not to Scale

GS 24

STATION PEAK HILL GEODETIC STATION TS 3687

Owner's Name: J. G. G. RESEKAR No. 44725 / Current Occupant: .....  
 Address: ..... Address: .....  
 Phone: ..... Phone: 4-2-1983

Access Report of 26/7/1982 was found unsuitable/unsuitable.


Kilometres

- 0.00 PEAK HILL POST OFFICE, TRAVEL EAST ALONG CORADREY STREET.
  - 0.27 TAKE TRUNK TO RIGHT, SIGN, OPEN CUT MINES.
  - 0.52 PASS OPEN CUT MINES ON L.H.S., FOLLOW ✓
  - 0.82 GRAVEL ROAD UP HILL. PEAK HILL GEODETIC STATION.
- ALL WEATHER ACCESS TO 2 WD VEHICLES ✓

Record of Station

Date

8: 2733-2 D. West, Government Printer

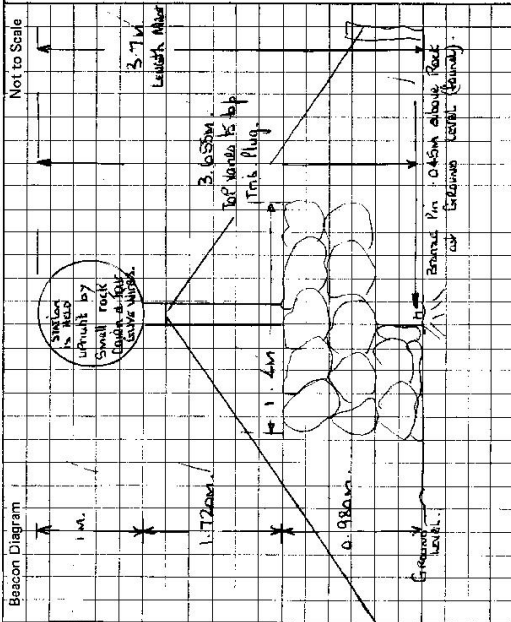

This section to be completed by officer constructing pillar.

Original station mark found/~~not found~~.

Description of mark: Beacon Pin

Original beacon found/~~not found~~.

Description of beacon: Pole, Cairn, 6 Discs

Height Top of Vanes to Top Mark: 3.655 m.

Height of mark: 0.45 m. above rock/~~above G.L.~~

Diameter of Vanes: 1.1 m.

Height of Cairn: 4.00 m.

Original Beacon ~~base~~ has not been destroyed by me.

LAND INFORMATION CENTRE

GEODETIC SURVEY OF N.S.W.

GEODETIC STATION RECONNAISSANCE and MAINTENANCE REPORT

Description:

1. Cleared by James bearing..... *CLEARED FOR GPS 150 ENDY* Note: Cross out word or words which do not apply from Trig. Mast

2. Mast & Vanes have been painted white & black respectively. —

3. The station/pillar was unplied/not unplied/constructed on..... 19....., dimensions now being:

Description of mark..... should be explicit, e.g., S/Steel Pillar Plate, Steel plug, Brass plug, Bolt, G.L. Pipe

Height of mark.....m. above rock/concrete; Mark is.....m. above G.L.

Height of Top Vanes to Top Mark/Pillar plate .....m. Diameter of Vanes (vertical).....m.

Height of Cairn.....m. Diameter of Cairn.....m. Name Plate found/not found/placed.

Length of Mast .....m. (approximate if not unplied)

- 4. A..... set in conc./rock has been placed/found, bearing.....°M from Mast/Plug/Pillar
- 5. A..... set in conc./rock has been placed/found, bearing.....°M from Mast/Plug/Pillar
- 6. A..... set in conc./rock has been placed/found, bearing.....°M from Mast/Plug/Pillar
- 7. A..... set in conc./rock has been placed/found, bearing.....°M from Mast/Plug/Pillar
- 8. Action required:.....

STANDPOINT:

STANDPOINT:

Mark	Direction	Horiz. Distance	Height Difference	Mark	Direction	Horiz. Distance	Height Difference
			above standpt.				above standpt.
			below				below standpt.
			above standpt.				above standpt.
			below				below standpt.

Prepared by: *S. Hill 13/12/95*

Checked:

Noted on U.T.M. Card

Checked

S: 2733-1

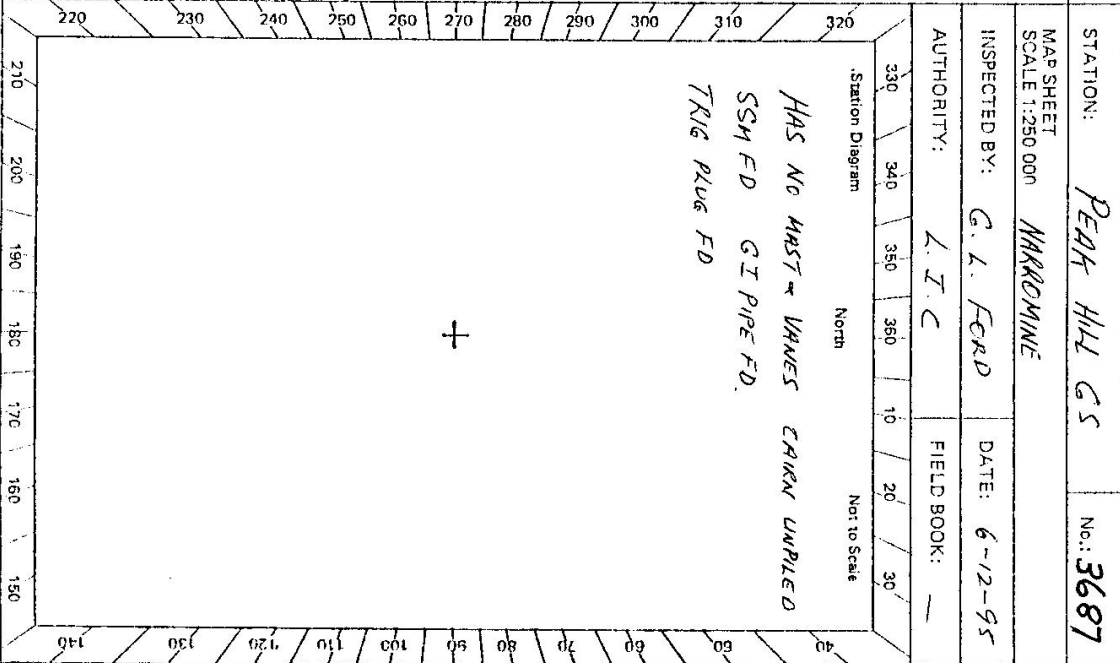

STATION: *PEARL HILL GS*

No.: *3687*

MAP SHEET SCALE 1:250 000 *NAKROMINE*

INSPECTED BY: *G. L. FORD* DATE: *6-12-95*

AUTHORITY: *L. I. C.* FIELD BOOK: *—*

Station Diagram North Not to Scale

