

GEODETIC SURVEY OF N.S.W.

CENTRAL MAPPING AUTHORITY


GEODETIC STATION RECONNAISSANCE and MAINTENANCE REPORT

STATION: **TENANG S.S.** No.: **3698**

MAP SHEET SCALE 1:250 000 **HOLLANDS**

INSPECTED BY: **M.L. Morrison** DATE: **21.11.78**

AUTHORITY: **C.M.A.** FIELD BOOK: **1711**

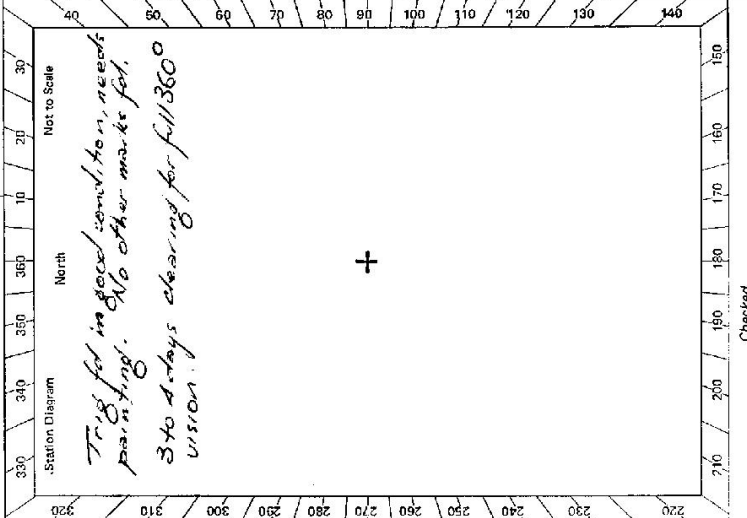

Description: *Note: Cross out word or words which do not apply*

1. Cleared by lanes bearing..... from Trig. Mast
2. Mast & Vanes have been painted white & black respectively.
3. The station/pillar was unpiled/not unpiled/constructed on.....19....., dimensions now being: Description of mark..... should be explicit, e.g., S/Steel Pillar Plate, Steel plug, Brass plug, Bolt, G.I. Pipe Height of mark.....m, above below Mark is.....m, above below
4. A.....set in conc/rock has been placed/found, bearing.....°M from Mast/Plug/Pillar
5. A.....set in conc/rock has been placed/found, bearing.....°M from Mast/Plug/Pillar
6. A.....set in conc/rock has been placed/found, bearing.....°M from Mast/Plug/Pillar
7. A.....set in conc/rock has been placed/found, bearing.....°M from Mast/Plug/Pillar
8. Action required:.....

STANDPOINT:			
Mark	Direction	Horiz. Distance	Height Difference
			above standpt.
			below standpt.
			above standpt.
			below standpt.
Prepared by: *[Signature]* Checked: *[Signature]* Noted on U.T.M. Card

St 27358 - 2 D. West, Government Printer

STATION FENNING TS 3698	Owner's Name: MR. YASTREBOFF Address: LITTLE FOREST CANYON/LEIGH Phone: 78 9178 Current Occupant: Address: Phone: ACCESS Access Report of 21/11/1978 was found suitable/suitable. Km Direction 0.00 ON HUME HWY 14 km South of BEERAMA AT CROSSROADS TAKE RD TO CANYON/LEIGH. 0.45 TURN RIGHT TOWARDS TEGALONG STATION 16.55 PASS NARROW RD ON LEFT. 21.65 PASS RD ON LEFT. 30.45 TURN RIGHT ONTO TRACK 30.80 KEEP LEFT OFF MAIN TRACK FOLLOW VERY FAINT OLD TRACK ALONG NARROW SPUR IN EASTERLY DIRECTION 32.05 PARK TRACK NEAR VERY LARGE ROCK. ABT 5-10 mins EASY WALK TO TRIG.
Beacon Diagram Not to Scale 	This section to be completed by officer constructing pillar. Original station mark found/not found. Description of mark: Original beacon found/not found. Description of beacon: Height Top of Vane to Top Markm. Height of markm. above G.L. / below rocks/concm. Diameter of Vanem. Height of Cairnm. Original Beacon has/has not been destroyed by me.
	Date Record of Station