

GEODETIC SURVEY OF M.S.W.

CENTRAL MAPPING AUTHORITY

GEODETIC STATION RECONNAISSANCE and MAINTENANCE REPORT

Description:
 1. Cleared by laser bearing.....
 Note: Cross out word or words which do not apply
 2. Mast & Vanes have been painted white & black respectively.
 3. The station/pillar was unpiled/not unpiled/constructed on.....19....., dimensions now being:
 Description of mark. **Grass Plug** should be explicit, e.g., S/Steel Pillar Plate, Steel plug, Brass plug, Bolt, G.I. Pipe
 Height of mark.....m. above rock/concrete; Mark is.....m. above G.I.L.
 Height of Top Vanes to Top Mark/Pillar platem. Diameter of Vanes (vertical).....m.
 Height of Cairn.....m. Diameter of Cairn.....m. Name Plate found/not found/placed.
 Length of Mast.....m. (approximate if not unpiled)
 4. A.....set in conc/rock has been placed/found, bearing.....°M from Mast/Plug/Pillar
 5. A.....set in conc/rock has been placed/found, bearing.....°M from Mast/Plug/Pillar
 6. A.....set in conc/rock has been placed/found, bearing.....°M from Mast/Plug/Pillar
 7. A.....set in conc/rock has been placed/found, bearing.....°M from Mast/Plug/Pillar
 8. Action required: **Average condition...surrounded by light timber...drive to...Back...Backed...**

STANDPOINT:

Mark	Direction	Horiz. Distance	Height Difference	Mark	Direction	Horiz. Distance	Height Difference
			above standpt.				above standpt.
			below				below
			above standpt.				above standpt.
			below				below
Prepared by: *Reling Sooki*

Checked: *Reling Sooki*

St 2753-1

Noted on U.T.M. Card

STATION: **S.M.A. 1156** No.: **37**
 MAP SHEET: **TANTANGARA I : 100,000**
 SCALE 1:250 000
 INSPECTED BY: **R. COOK** DATE: **8-3-79**
 AUTHORITY: **C.M.A.** FIELD BOOK:



GS 24

STATION **S.M.A. 1156 TS 37**

Owner's Name:
 Address: **Situbandak, Lathim, H.A., KARANGASO NATIONAL PARK**
 Phone:

Current Occupant:
 Address:
 Phone:

ACCESS
 Access Report of 2/12/1979 was found suitable/unsuitable.

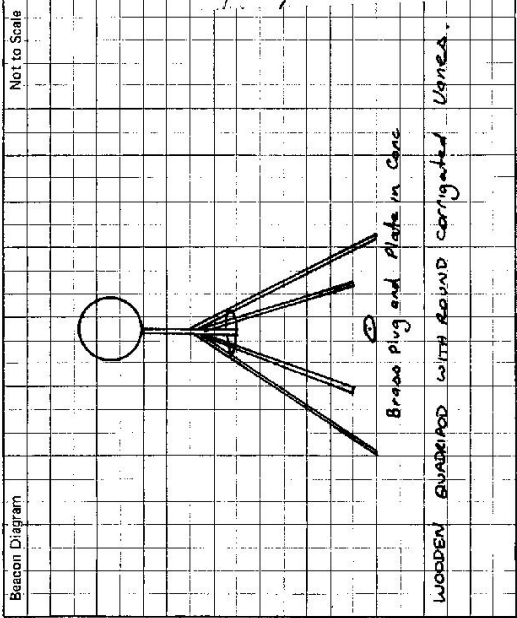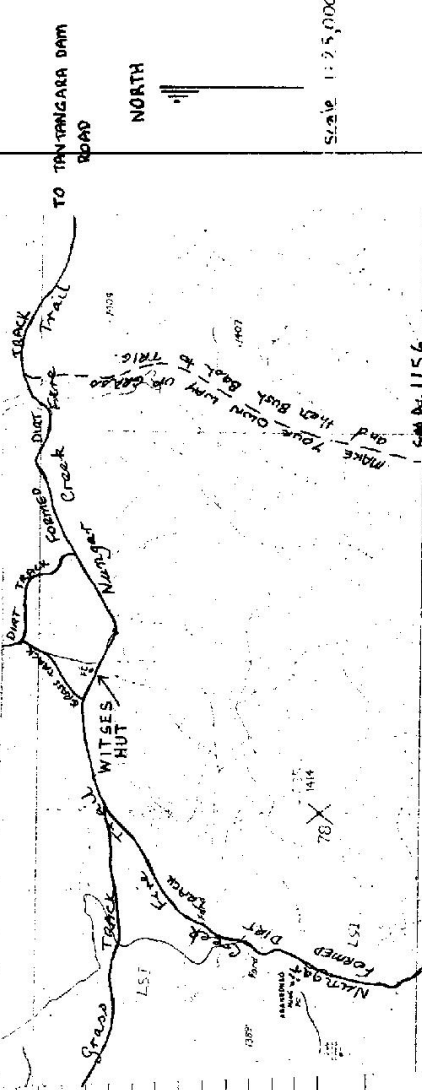

This section to be completed by officer constructing pillar.

Original station mark found/not found.

Description of mark:

Original beacon found/not found.

Description of beacon:

Height Top of Vanes to Top Mark:m.

Height of mark:m. above G.L.
m. below

Diameter of Vanesm. Height of Cairnm.

Original Beacon has/has not been destroyed by me.

Nanger Creek Fire trail
 Date **8-3-79**
 To **ALPINE MOUNTAINS**
 Record of Station

Alpine Creek Fire Trail
 Date **8-3-79**
 To **ALPINE MOUNTAINS**
 Record of Station

Reconnaissance of Trig during field completion of Tantangara 1:25,000
 Access taken off the Tantangara 1:25,000 Provisional.