

CENTRAL MAPPING AUTHORITY
Department of Lands

Trigonometrical Survey of N.S.W.

RECONNAISSANCE and MAINTENANCE REPORT

STATION PERISHER G.S. TS 3707

This Trig. Station has been:-

Note: Cross out word or words which do not apply

1. Completely cleared to permit 360° vision to surrounding Trigs.
2. Cleared by lanes bearing 360° VISION from Trig. Mast
3. Trig. Mast & Vanes have been painted white & black respectively.
4. The Trig. ~~was supplied/met supplied~~, dimensions now being: 1.22m ~~1.22m~~ ~~not found~~

Description of mark: 1/2" STEEL PIPE IN ROCK ED. should be explicit, e.g. Steel plug, Brass plug, Bolt, G.L. Pipe

Height of mark: 1/2" above m above rock/concrete below m below G.L. Diameter of Vanes (vertical)..... m.

Height of Top Vanes to Top Mark..... m. Diameter of Cairn..... m.

Height of Cairn..... m. (approximate if not unplied)

5. A..... set in conc/rock has been placed..... m. bearing.....°M from Trig. Mast
6. A..... set in conc/soil has been placed..... m. bearing.....°M from Trig. Mast
7. A..... set in conc/soil has been placed..... m. bearing.....°M from Trig. Mast
8. A..... set in conc/rock has been placed..... m. bearing.....°M from Trig. Mast

9. Connection..... to..... m. bearing.....°M

10. Connection..... to..... m. bearing.....°M

11. Connection..... to..... m. bearing.....°M

12. Connection..... to..... m. bearing.....°M

13. Diff. Ht. is..... m. ^{above} _{below}

14. Diff. Ht. is..... m. ^{above} _{below}

15. Diff. Ht. is..... m. ^{above} _{below}

16. Diff. Ht. is..... m. ^{above} _{below}

Prepared by: Alan Woodruff Checked: John Brown 12-5-77 Noted on U.T.M. Card


Co:

Map Sheet: KOSCIUSKO 1: 100,000 No:

Inspected by: A WOODRUFF, W MILLER Date: 17th FEBRUARY 77

Authority: CENTRAL MAPPING Field Book: 1531

Beacon Diagram Not to Scale

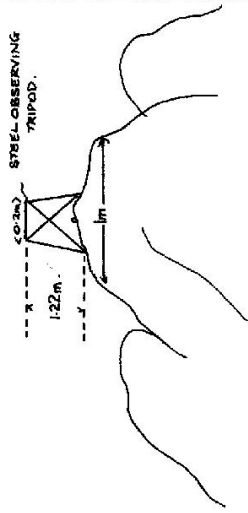

Date

Record of Station

Checked

