

CENTRAL MAPPING AUTHORITY

GEODETTIC SURVEY OF N.S.W.

GEODETTIC STATION RECONNAISSANCE and MAINTENANCE REPORT


STATION: *Pini Ridge* No.: *3739*

MAP SHEET SCALE 1:250 000

Culgandra

INSPECTED BY: *R.K. Bamole* DATE: *23/1/19*

AUTHORITY: *CMA* FIELD BOOK:

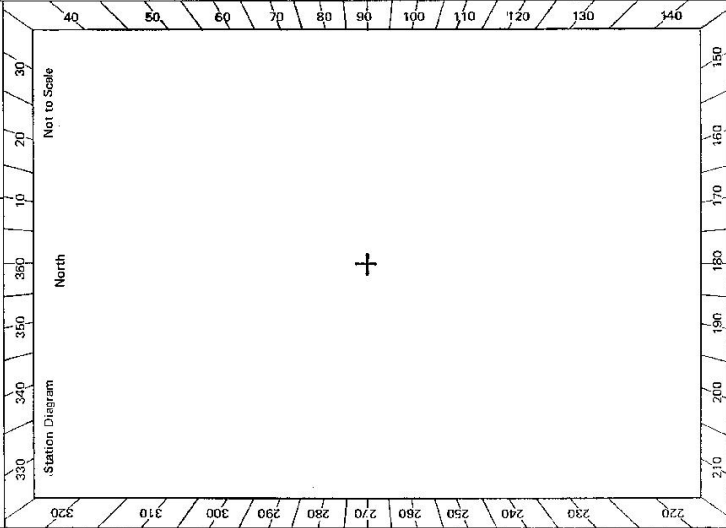

Description:

Note: Cross out word or words which do not apply

1. Cleared by lanes bearing.....
2. Mast & Vanes have been painted white & black respectively.
3. The station/pillar was unpiled/not unpiled/constructed on.....*19*..... dimensions now being:
Description of mark.....should be explicit, e.g., S/Steel Pillar Plate, Steel plug, Brass plug, Bolt, G.I. Pipe
Height of mark.....m. ^{above} rock/concrete; Mark is.....m. ^{above} G.L.
Height of Top Vanes to Top Mark/Pillar platem. Diameter of Vanes (vertical).....m.
Height of Cairn.....m. Diameter of Cairn.....m. Name Plate found/not found/Placed.
Length of Mast.....m. (approximate if not unpiled)
4. A.....set in conc/rock has been placed/found, bearing.....° M from Mast/Plug/Pillar
5. A.....set in conc/rock has been placed/found, bearing.....° M from Mast/Plug/Pillar
6. A.....set in conc/rock has been placed/found, bearing.....° M from Mast/Plug/Pillar
7. A.....set in conc/rock has been placed/found, bearing.....° M from Mast/Plug/Pillar

8. Action required: *According to Property Owner Cairn mast & discs exist. Some clearing required*

STANDPOINT:			
Mark	Direction	Horiz. Distance	Height Difference
			above standpt.
			below
			above standpt.
			below
Prepared by: *Shirley* 24/1/19 Checked: *Checked*

Noted on U.T.M. Card

CR 2739-2 E. West, Government Printer

Beacon Diagram: No: to Scale

This section to be completed by officer constructing pillar.

Original station mark found/not found.

Description of mark:
.....

Original Beacon found/not found.

Description of beacon:
.....

Height Top of Vanes to Top Mark.....m.

Height of mark.....m. above rock/concm. above G.L.

Diameter of Vanesm. Height of Cairnm.

Original Beacon has/had/nas not been destroyed by ma.

STATION **PINE RIDGE 3739**


Owner's Name: **HR DON FINLAY**
 Address: **G.I - Don**
Via MULLENBY
 Phone: **67 437846**

Current Occupant:
 Address:
 Phone:

Access Report of.../15... was found suitable/unsuitable.

ACCESS:
 ACCESS DIAGRAM
 Not To Scale
 Based on GCSMADA 1:250000
 Distances in miles & KM

- 0.0 **KLH** LEAVE VEHICLE SWIM GRAY WALK
- 0.1 LEFT OFF TRACK MAKE OWN WAY
- 0.45 HAND LEFT ALONG DAM WALL
- 0.7 END HIGH FENCE (CROSS)
- 1.1 RIGHT ALONG FENCE
- 1.3 RIGHT THROUGH QUARRY
- 1.85 STRAIGHT AHEAD THROUGH GATE THEN TAKE TRACK TO RIGHT
- 4.2 PASS GATE ON LEFT HONTANA.

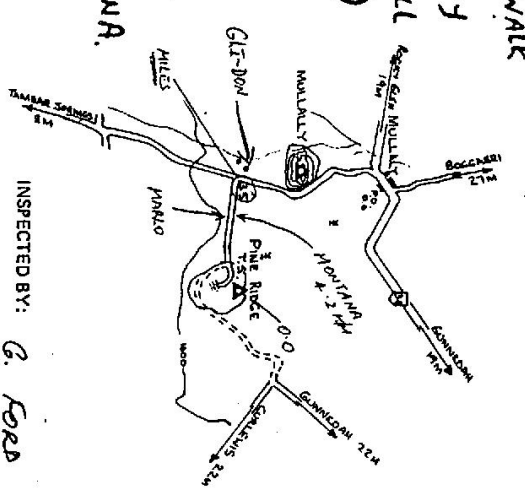

INSPECTED BY: **G. Ford**

Date	Record of Station
Cleared by Janes bearing: QHIS SAKE TO MULLENBY TRAIL NEERS CLEARING C.RS. WEERS CLEARING	from Trig. Mast
A. SEA 1625 set in conc/seek has been placed found, bearing..... M from Mast/Plug/Pillar	