
TS3756 | Print Date: 31/05/2022 16:21 | No Of Pages: 2 | Property of DFSI – Spatial Services

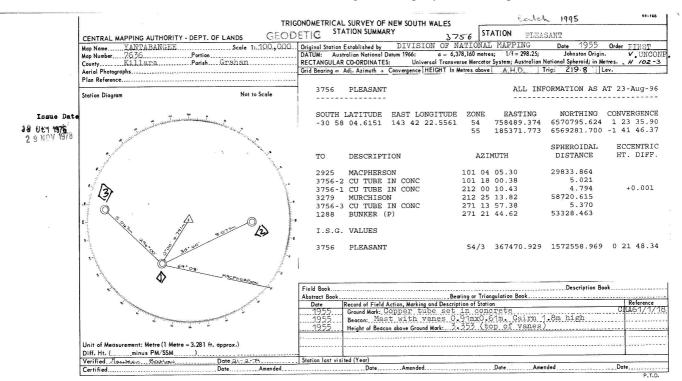

					STATION	PLEASANT		
			CO-ORDINATES IN C	THER SYSTEMS				
A.N.G. (Clarke 1858) T.M.		INTEG	INTEGRATED SURVEYS GRID ((Central Scale Factor 0.9999)		CASSINI-SOLDNER GRID.	
YARDS		METRES		FEET		Unit:		
Zone: C.M.		Zone: 54/3 C.M. 143		Zone: C.M.		Origin:		
E	N	Mapping	N	E	N	LATITUDE	DEPARTURE	
	·	367 470.930	1572 558.972					
	· · ·				at .above Mean Sea Level	PROVISIONAL	FINAL	
				HEIGHT in Met	res above Mean Sea Level			
			HISTORY OF STATIO	N				
				Field Action, Marking an	d Description of Station		Referenc	
					see.over.R.M's-3.	conner tuber co		
			concre	te Access sunn'	lied			
			19.7.96 Station	visited. Not u	inpiled. Two witnes	s marks found. Ne	a access	
			Beacon	details & other attrib	utes entered			
				IMS 2000 database				
				Chapman	Visits Completed			
			Deter (23/2/01	47.			
			Date:	2312101				
						••••		
							······	
			·····					
		*						
				•••••••••••••••••••••••••••••••••••••••				