

GEODEIC SURVEY OF N.S.W.

CENTRAL MAPPING AUTHORITY

GEODEIC STATION RECONNAISSANCE and MAINTENANCE REPORT

STATION: **PLEVNA** No.: **3758**

MAP SHEET SCALE 1:250 000 **NARRORINE**

INSPECTED BY: **D.R. BARNOLA** DATE: **24/9/78**

AUTHORITY: **C.M.A.** FIELD BOOK:

Description:
 1. **Cleared by lanes bearing.** Note: Cross out word or words which do not apply
 2. **Mast & Vanes have been painted white & black respectively, found in cairn of rocks**
 3. **The station/pillar was unplied/not unplied/constructed on..... 49..... dimensions now being:**

Description of mark..... should be explicit, e.g., S/Steel Pillar Plate, Steel plug, Brass plug, Bolt, G.I. Pipe
 Height of mark..... above/below rock/concrete; Mark is..... m. above/below G.I.L.
 Height of Top Vanes to Top Mark/Pillar plate..... m. Diameter of Vanes (vertical)..... m.
 Height of Cairn..... m. Diameter of Cairn..... m. Name Plate found/not found/obscured.
 Length of Mast..... m. (approximate if not unplied)


4. A..... set in conc/rock has been placed/found, bearing..... M from Mast/Plug/Pillar
 5. A..... set in conc/rock has been placed/found, bearing..... M from Mast/Plug/Pillar
 6. A..... set in conc/rock has been placed/found, bearing..... M from Mast/Plug/Pillar
 7. A..... set in conc/rock has been placed/found, bearing..... M from Mast/Plug/Pillar

8. Action required: **Mast & Vanes to be painted as explained. 3 days. Clearing.....**

STANDPOINT:

Mark	Direction	Horiz. Distance	Height Difference	Mark	Direction	Horiz. Distance	Height Difference
			above standpt				above standpt
			below				below
			above standpt				above standpt
			below				below
Prepared by:
 Checked:
 Noted on U.T.M. Card

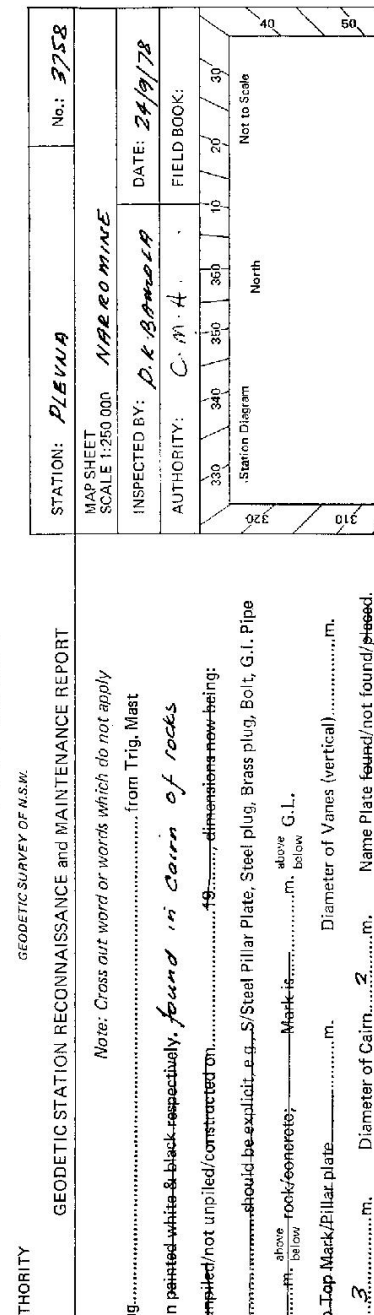

140
135
130
320
310
300
290
280
270
260
250
240
230
220

Station Diagram
North
Not to Scale

210 200 190 180 170 160 150

Checked

