

CENTRAL MAPPING AUTHORITY

GEODETIC SURVEY OF M.S.K.

GEODETIC STATION RECONNAISSANCE and MAINTENANCE REPORT

STATION: **PLUMB** No.: **TS 3760**

MAP SHEET SCALE 1:250 000

Goulburn

INSPECTED BY: **A. Sivertsen** DATE: **10-10-78**

AUTHORITY: **CMA** FIELD BOOK: **1643**

- Description:**
- Cleared by lanes bearing **48.55** ^{above} **3.78** ^{below} **9.07m** from Trig. Mast **10-41 light timber**
2 days clearing 360 - no objection from owner 56-78 2 distant trees
 - Mast & Vanes have been painted white & black respectively. **cairn, mast & vanes**
90-100} 200m
in poor condition
 - The station/pillar was unplied/not unplied, **reinstated** on **19** dimensions now being:
Description of mark **.....** should be explicit, e.g., S/Steel Pillar Plate, Steel plug, Brass plug, Bolt, G.I. Pipe
Height of mark **.....** ^{above} **.....** ^{below} **.....** m. Mark is **.....** ^{above} **.....** ^{below} **.....** m. G.L.
Height of Top Vanes to Top Mark/Pillar plate **.....** m. Diameter of Vanes (vertical) **1.0** ^{above} **.....** ^{below} **.....** m.
Height of Cairn **1.5** m. Diameter of Cairn **2.5** m. Name Plate **found/not found/placed**.
Length of Mast **4.3** m. (approximate if not unplied)
 - A **.....** set in conc/rock has been placed/found/bearing **.....** °M from Mast/Plug/Pillar
 - A **.....** set in conc/rock has been placed/found, bearing **.....** °M from Mast/Plug/Pillar
 - A **.....** set in conc/rock has been placed/found, bearing **.....** °M from Mast/Plug/Pillar
 - A **.....** set in conc/rock has been placed/found, bearing **.....** °M from Mast/Plug/Pillar
 - Action required **.....**

TOWRANG
1:25000


STANDPOINT:				STATION POINT:			
Mark	Direction	Horiz. Distance	Height Difference	Mark	Direction	Horiz. Distance	Height Difference
			above standpt.				above standpt.
			below				below
			above standpt.				above standpt.
			below				below
Prepared by: *[Signature]*

Checked: *[Signature]*


Noted on U.T.M. Card

Checked

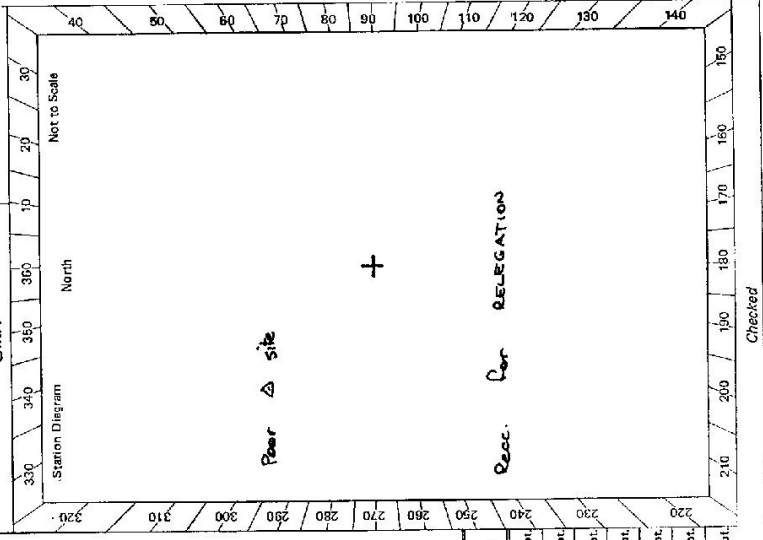

GS

STATION	PLUMB	TS 3760
Owner's Name: D.H. CROSBY	Current Occupant:	
Address: "Ross Farm"	Address:	
Phone: MARUHAN	Phone:	
ACCESS		
Access Report of 18/10/1978 was found suitable/unsuitable.		
0.0 Turn off Hwy. at grid "Ross Farm"		
0.25 Grid		
0.3 Take road to left pass sheds		
0.45 Grid		
0.8 Take R fork thru iron gate (left to owners)		
1.1 Pass track on L		
1.25 Gate		
1.3 Take track to L up right side of firebreak		
1.6 Gate. Make own way to Δ along firebreak		
1.7 PLUMB Δ		

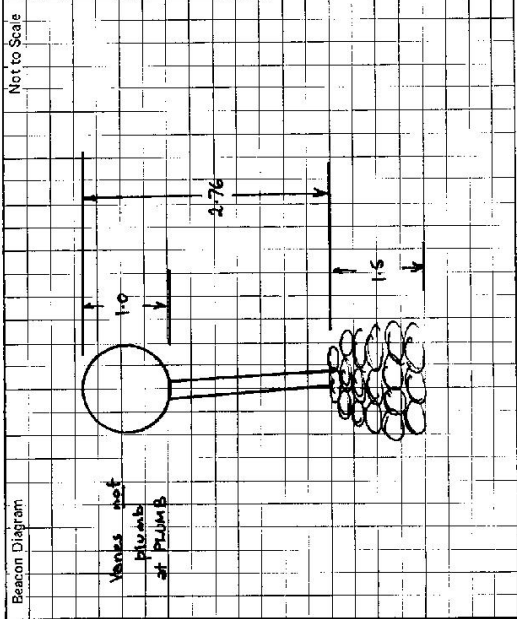

This section to be completed by officer constructing pillar.

Original station mark found/not found.

Description of mark:

Original beacon found/not found.

Description of beacon:

Height Top of Vanes to Top Mark.....m.

Height of mark.....m. above G.L. below rock/stone.....m. below

Diameter of Vanesm. Height of Cairnm.

Original Beacon has/has not been destroyed by me.

Date	Record of Station

GEODETTIC SURVEY OF N.S.W.

CENTRAL MAPPING AUTHORITY

GEODETTIC STATION RECONNAISSANCE and MAINTENANCE REPORT

STATION: **PLUMB** No.: **3760**

MAP SHEET
SCALE 1:250 000 **Goulburn**

INSPECTED BY: **M Clark** DATE: **3.4.81**

AUTHORITY: **C.M.A** FIELD BOOK:

Station Diagram North
Not to Scale

- Description: *Note: Cross out word or words which do not apply*
1. Cleared by lances bearing..... from Trig. Mast
 2. Mast & Vanes have been painted white & black respectively.
 3. The station/pillar was unpiled/not unpiled/constructed on..... 19..... dimensions now being:
Description of mark..... should be explicit, e.g., S/Steel Pillar Plate, Steel plug, Brass plug, Bolt, G.I. Pipe
Height of mark.....m. above rock/concrete; Mark is.....m. above below G.L.
 4. A..... set in conc/rock has been placed/found, bearing.....° M from Mast/Plug/Pillar
 5. A..... set in conc/rock has been placed/found, bearing.....° M from Mast/Plug/Pillar
 6. A..... set in conc/rock has been placed/found, bearing.....° M from Mast/Plug/Pillar
 7. A..... set in conc/rock has been placed/found, bearing.....° M from Mast/Plug/Pillar
 8. Action required:.....

Height of Top Vanes to Top Mark/Pillar platem. Diameter of Vanes (vertical).....m.

Height of Cairn.....m. Diameter of Cairn.....m. Name Plate found/not found/placed.

Length of Mast.....m. (approximate if not unpiled)

STANDPOINT:

Mark	Direction	Horiz. Distance	Height Difference	Mark	Direction	Horiz. Distance	Height Difference
			above standpt. below				above standpt. below
			above standpt. below				above standpt. below
Prepared by: **Michael Clark** 13-5-81 Checked: **AG** *Note on U.T.M. Card*

