

75-10-a

Integration Key of N.S.W.

Department of Lands

RECONNAISSANCE and MAINTENANCE REPORT 3765 STATION

POGSON (P)

This Trig. Station has been:-

Note: Cross out word or words which do not apply


1. ~~Completely cleared to permit 360° view to surrounding Trig.~~
2. Cleared by lances bearing 280° to 350° ; 70° ; 80° ; 150° from Trig. Mast
3. Trig. Mast & Vanes have been painted white & black respectively.
4. The Trig. was unpiled/~~not unpiled~~, dimensions now being:

Description of mark: Concrete Pillar should be explicit, e.g. Steel plug, Brass plug, Bolt, Concrete Pillar
 Height of mark: 1.37 m above ~~rock~~ concrete 1.47 m above G.L.
 Height of Top Vanes to Top Mast/Top pillar plate 1.475 m Diameter of Vanes (vertical) 0.6 m.
 Height of Centre 1.56 m Diameter of Centre 0.665 m.

- Length of Mast 1.56 m. (approximate if not unpiled)
5. A. 20207 set in conc/~~rock~~ has been placed/~~is~~ 2.999 m. bearing 150° from Trig. Mast/pillar
 6. A. 20208 set in conc/~~soil~~ has been placed/~~is~~ 2.999 m. bearing 280° from Trig. Mast/pillar
 7. A. 20207 set in conc/soil has been placed/~~is~~ 5.487 m. bearing 124° from Trig. Mast/pillar
 8. A. 20208 set in conc/rock has been placed/~~is~~ 2.999 m. bearing 150° from Trig. Mast/pillar
 9. Connection Pillar 20207 to 20208 is 1.579 m. bearing 280°
 10. Connection Pillar 20208 to 20207 is 1.612 m. bearing 104°
 11. Connection 20208 to 20207 is 0.033 m. bearing 20207
 12. Connection 20207 to 20208 is 0.033 m. bearing 20207
 13. Diff. Ht. 20207 is 1.579 m. ~~above~~ below Pillar Plate
 14. Diff. Ht. 20208 is 1.612 m. ~~above~~ below Pillar Plate
 15. Diff. Ht. 20208 is 0.033 m. ~~above~~ below 20207
 16. Diff. Ht. 20207 is 0.033 m. ~~above~~ below 20208

Prepared by: *CCP* Checked: *26/10/76* Date: *24/10/76*


Co: CUMBERLAND Ph: STH COLAH
 Map Sheet: DURAL No: 0067
 Inspected by: C.W. JEREMY Date: DEC. 1975
 Authority LANDS Field Book: PDP 399

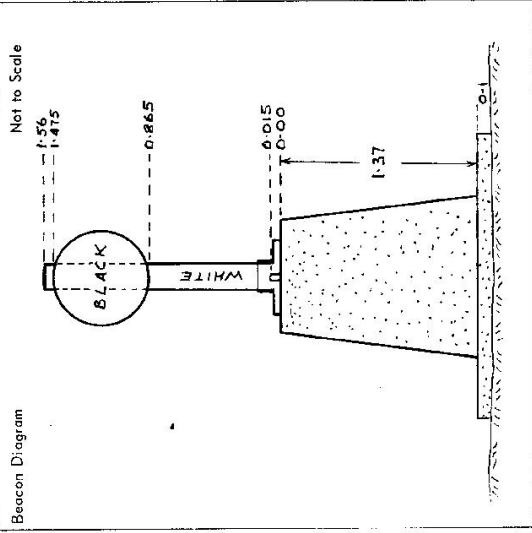

Date	Record of Station
24/10/76	Concrete Pillar erected over original plug

STATION T.S. POGSON (P) TS 3765

Owners Name:
 Current Occupant:
 Address:
 Address:

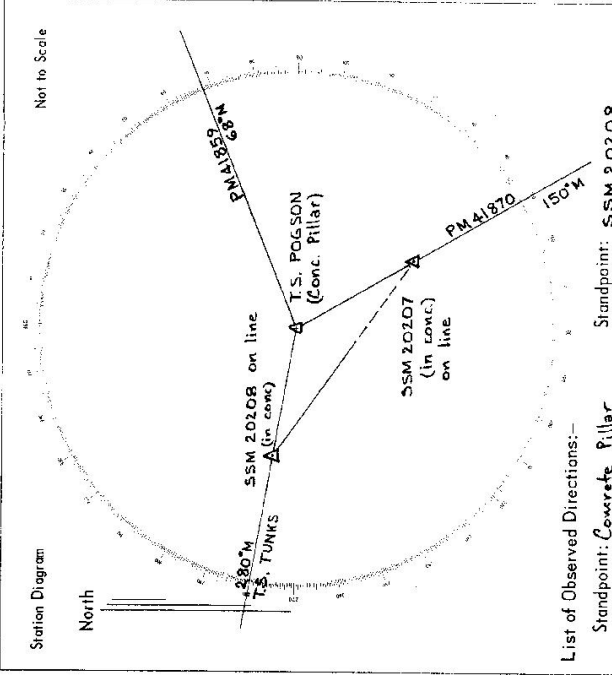

List of Observed Directions:-

Standpoint: Concrete Pillar		Standpoint: SSM 20208	
Station	Direction	Station	Direction
T.S. TUNKS	0 00 00	T.S. TUNKS (pillar)	0 00 00
PM 41870	147 55 58.5	T.S. POGSON (pillar)	179 59 20
SSM 20207	227 39 25	SSM 20207	203 49 20
PM 41870	227 39 36.9		
SSM 20208	359 59 25		

Access
 Del M75 (Conventional vehicle) (KEY REQUIRED)
 Km. 00 Turn off Old Northern Rd., Dual into Quarry Rd. UBD MAP 25:87
 1-9 TELECOM Towers (2) on right
 3-2 End of bitumen
 3-7 "No thoroughfare" sign at sharp bend
 3-8 Pink shed on left
 4-1 Fire trail gate (Key from Hornsby Council or from Integration Surveys Division)
 4-5 T.S. POGSON on clearing beside road (on right)
 (If any difficulties encountered on access obtain alternative treadskous access from Hornsby Council Fire Patrol Officer.)

Station	Direction	Station	Direction