

CENTRAL MAPPING AUTHORITY

GEODETIC SURVEY OF NSW
 GEODETIC STATION RECONNAISSANCE and MAINTENANCE REPORT

STATION: **DPILTAH G.S. (NW/CL/10)** No.: **3778**


MAP SHEETS SCALE 1:250 000 ANA BRANLCH. SCALE 1:100 000

INSPECTED BY: **G DICKSON** DATE: **25.7.91**

AUTHORITY: **L.I.L.** FIELD BOOK: **2105**

Description:
 1. Cleared by lanes bearing..... Note: Cross out word or words which do not apply from Trig. Mast
 2. Mast & Vanes have been painted white & black respectively.
 3. The station/pillar was unpiled/not unpiled/constructed on..... 19....., dimensions now being:
 Description of mark..... should be explicit, e.g., S/Steel Pillar Plate, Steel plug, Brass plug, Bolt, G.I. Pipe
 Height of mark..... m. ^{above}/_{below} rock/concrete; Mark is..... m. ^{above}/_{below} G.L.
 Height of Top Vanes to Top Mark/Pillar plate..... m. Diameter of Vanes (vertical)..... m.
 Height of Cairn..... m. Diameter of Cairn..... m. Name Plats found/not found/placed.
 Length of Mast..... m. (approximate if not unpiled)

4. A..... set in conc/rock has been placed/found, bearing..... °M from Mast/Plug/Pillar
 5. A..... set in conc/rock has been placed/found, bearing..... °M from Mast/Plug/Pillar
 6. A..... set in conc/rock has been placed/found, bearing..... °M from Mast/Plug/Pillar
 7. A..... set in conc/rock has been placed/found, bearing..... °M from Mast/Plug/Pillar
 8. Action required:.....

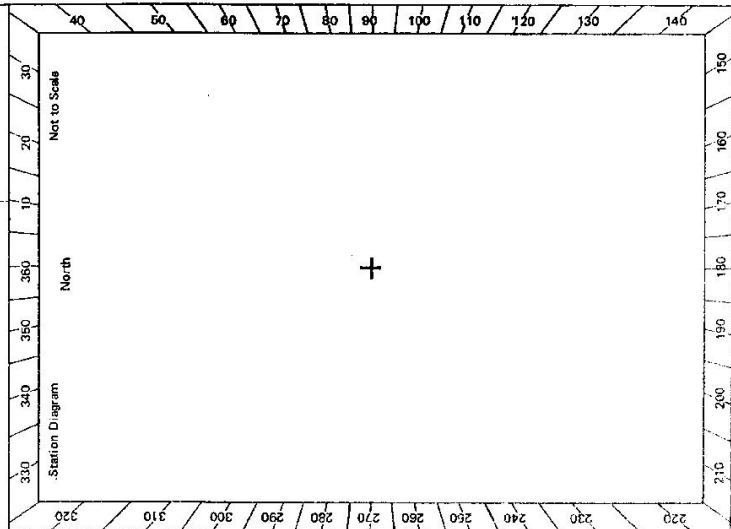

STANDPOINT:

Mark	Direction	Horiz. Distance	Height Difference	Mark	Direction	Horiz. Distance	Height Difference
			above standpt.				above standpt.
			below standpt.				below standpt.
			above standpt.				above standpt.
			below standpt.				below standpt.
Prepared by: *[Signature]* Checked: *[Signature]* Noted on U.T.M. Card

LAND INFORMATION CENTRE

GEODETTIC SURVEY OF A.S.M.

GEODETTIC STATION RECONNAISSANCE and MAINTENANCE REPORT

STATION: **POPILTAH** No.: **3778**

MAP SHEET SCALE 1:250 000

INSPECTED BY: **L. HITCHINS**

DATE: **20.8.91**

AUTHORITY: **L.I.C.**

FIELD BOOK: **630**


Description: *Note: Cross out word or words which do not apply*

- Cleared by lanes bearing..... from Trig. Mast
- Mast & Vanes have been painted white & black respectively.
- The station/pillar was unpiled/not unpiled/constructed on..... 19....., dimensions now being: Description of mark..... should be explicit, e.g., S/Steel Pillar Plate, Steel plug, Brass plug, Bolt, G.I. Pipe
- Height of mark..... m. above rock/concrete; Mark is..... m. above G.L.
- Height of Top Vanes to Top Mark/Pillar plate m. Diameter of Vanes (vertical)..... m.
- Height of Cairn..... m. Diameter of Cairn..... m. Name Plate found/not found/placed.
- Length of Mast..... m. (approximate if not unpiled)
- A. **Copper tube 1**..... set in conc/rock has been placed/found, bearing.....°M from Mast/Plug/Pillar
- A. **Copper tube 2**..... set in conc/rock has been placed/found, bearing.....°M from Mast/Plug/Pillar
- A. **Copper tube 3**..... set in conc/rock has been placed/found, bearing.....°M from Mast/Plug/Pillar
- A..... set in conc/rock has been placed/found, bearing.....°M from Mast/Plug/Pillar

8. Action required:.....

Mark	Direction	Horiz. Distance	Height Difference	Mark	Direction	Horiz. Distance	Height Difference	STANDPOINT: NM/C10 Copper tube in Conc	
								above standpt.	below standpt.
EURILLA	0 00 00		above standpt.	EURILLA	0 00 00		above standpt.	STANDPOINT: RM 2 Copper tube in Conc	
RM 3 Copper tube	46 34 20	6 402	above standpt.	RM 3 Copper tube	145 34 00	13 248	0 351		
RM 1 Copper tube	278 42 20	9 451	above standpt.	Popilth Copper tube	169 28 55	15 591	0 204		
RM 2 Copper tube	349 30 10	15 591	above standpt.	RM 1 Copper tube	205 03 00	15 344	0 200		
			below standpt.						
			above standpt.						
			below standpt.						
			above standpt.						
			below standpt.						

Prepared by: *[Signature]* Checked: *[Signature]* 1.10.91 Noted on U.T.M. Card

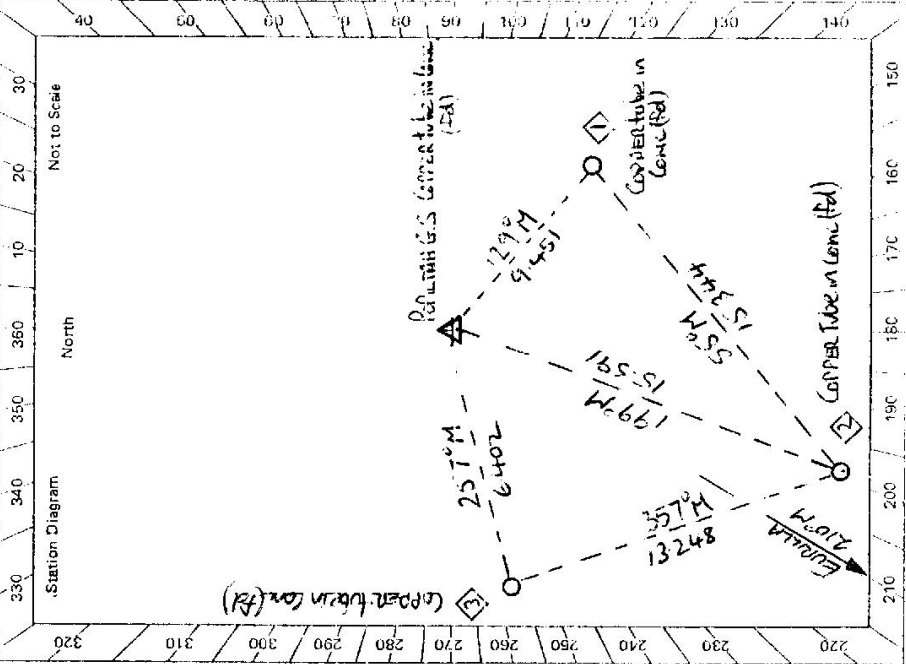

GS 24

STATION POPILTAH G.S. (NW/L/10) TS 3778

Owner's Name: MR. PETER CRETTON DEN.
 Address: Popiltah, H.S.
 Silver City HWY
 Popiltah (C/S) 271 240

Current Occupant:
 Address:
 Phone:

ACCESS:

Access Report of 25.7.1991 was found suitable/unsuitable.


RMS

- 0 00
- 25 70
- 25 90
- 28 70
- 33 60
- 34 70
- 35 10
- 37 15
- 37 60
- 41 55
- 49 15
- 55 30
- 56 40

FEATURE

- Coonkuk Roadhouse. Travel South.
- Turn left. Sign 'Popiltah 6 Miles.'
- Grid
- Grid.
- Turn left at signpost 'Popiltah.'
- Grid.
- H.S. turnoff on L.H.S.
- Grid.
- Turn left off road just before grid. Follow fence.
- Top of sand dune Turn left along top of dune. travelling south to Trig.
- Popiltah G.S.

(The 25 min from Coonkuk Roadhouse.)

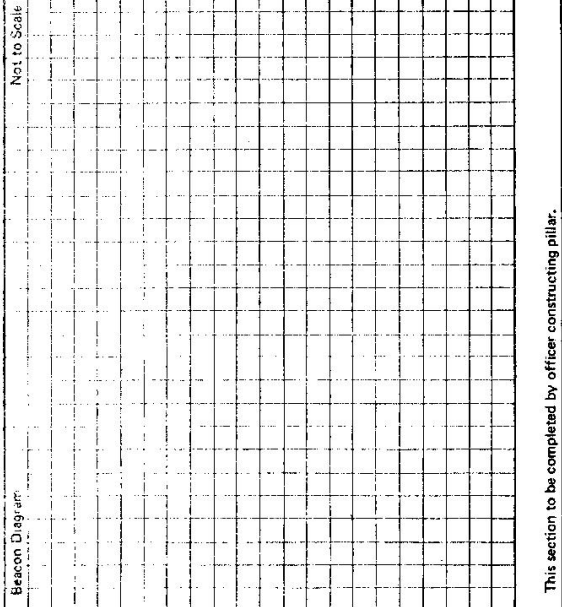

SI 2735-2 D. West. Government Printer

Beacon Diagram

This section to be completed by officer constructing pillar.

Original station mark found/not found.

Description of mark:

Original beacon found/not found.

Description of beacon:

Height Top of Vanes to Top Mark.....m.

Height of mark.....m. above G.L. below

Diameter of Vanesm. Height of Cairnm.

Original Beacon has/has not been destroyed by me.

Date	Record of Station