

Department of Lands

TS3781 82 096

Central Supply Authority

Trigonometrical Survey of N.S.W.

RECONNAISSANCE and MAINTENANCE REPORT on Forest TRIG. STATION

Parish Cowan County Comberland Map Sheet Rowen Bay No. A17

Inspected by [Signature] Date of Inspection 26. June 1957

is Trig. Station has been: Note: Cross out word or words which do not apply


1. ~~Completely cleared to permit 360° vision to surrounding Trigs.~~
2. ~~Cleared by lanes bearing _____ from Trig. Mast~~
3. The Trig. was unpiled/~~not unpiled~~, dimensions now being:
 - Original Trig. Plug was found/~~not found~~.
 - ~~Length of Mast _____ feet (approximate if not unpiled)~~ Mast (Round _____ feet diameter
(Square _____ feet)
 - Height of Trig. Plug 0.1 feet (above rock/concrete)
 - Height of Top Vanes to Top Trig. Plug _____ feet Diameter of Vanes (vertical) _____ feet
 - Height of Cairn _____ feet Diameter of Cairn _____ feet

(If other type Trig. beacon is erected - Diagram is required below in Remarks)

4. ~~Trig. Mast & Vanes have been painted white & black respectively.~~
5. An S.S.M. set in conc/rock has been placed _____ feet bearing _____ M to Trig. Mast/Plug.
6. A G.I. Pipe set in conc/soil has been placed _____ feet bearing _____ M to Trig. Mast/Plug.
7. ~~Connection S.S.M. to G.I. Pipe _____ feet bearing _____ M~~

REMARKS:- (To include diagram of marks placed)

North This trig plug is now covered with a steel P.M. cover box, Cairn has been left unpiled.

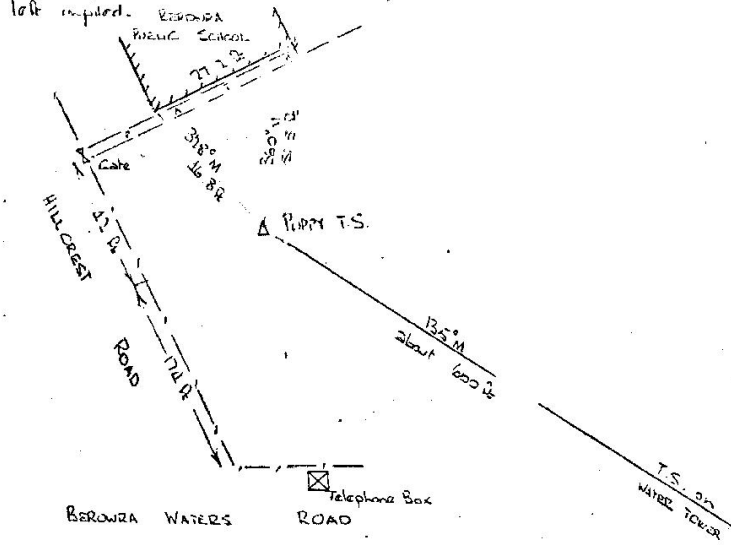

card noted
Sullivan
27/11/70. / /

Signature [Signature]

Department of Lands

CONSERVATION

Trigonometrical Survey of N.S.W.

RECONNAISSANCE and MAINTENANCE REPORT on PARLY TS 3781 TRIG. STATION

Parish COWAN County LUMBERLAND Map Sheet SYDNEY No. A150-11

Inspected by R. HANNA Date of Inspection 21.05.72

This Trig. Station has been:-

Note: Cross out word or words which do not apply

1. Completely cleared to permit 360° vision to surrounding Trigs.
2. Cleared by lanes bearing from Trig. Mast
3. The Trig. was unpiled/not unpiled, dimensions now being:

Original Trig. Plug was ~~found~~/not found.

Length of Mast.....feet (approximate if not unpiled)	Mast (Round.....feet diameter (Square.....feet
Height of Trig. Plug.....feet (above rock/concrete)	Diameter of Vanes (vertical).....feet
Height of Top Vanes to Top Trig. Plug.....feet	Diameter of Cairn.....feet
Height of Cairn.....feet	

(If other type Trig. beacon is erected - Diagram is required below in Remarks)

4. Trig. Mast & Vanes have been painted white & black respectively.
5. An S.S.M. set in conc/rock has been placed.....feet bearing.....°M to Trig. Mast/Plug
6. A G.I. Pipe set in conc/soil has been placed.....feet bearing.....°M to Trig. Mast/Plug
7. Connection S.S.M. to G.I. Pipe.....feet bearing.....°M

REMARKS:- (To include diagram of marks placed)

North

NO MARKS FOUND

David Hann

CHIEF TRIGONOMETRICAL SURVEYOR

21 5 72

CARDS NOTED: MICHAEL HUNTER

Signature.....*M. Hanna*.....26.3.72