

GEODETTIC SURVEY OF N.S.W.

CENTRAL MAPPING AUTHORITY


GEODETTIC STATION RECONNAISSANCE and MAINTENANCE REPORT

STATION: **ROUND** No.: **3789**

MAP SHEET SCALE 1:250 000 **SYDNEY**

INSPECTED BY: **P. NAYLOR** DATE: **22/8/79**

AUTHORITY: **C.M.A.** FIELD BOOK:

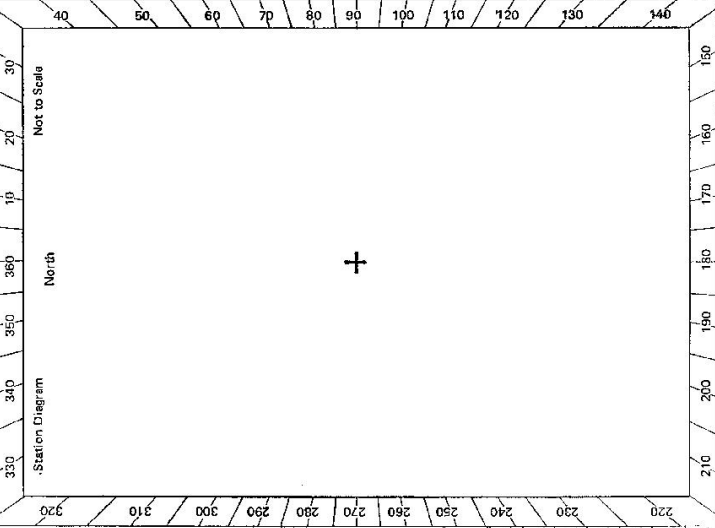


- Description:
- Note: Cross out word or words which do not apply
- Cleared by lances bearing..... from Trig. Mast
 - Mast & Vanes have been painted white & black respectively.
 - The station/~~faller~~ was unplied/~~replaced~~ on ~~22/8/79~~ **19.79**, dimensions now being: ~~2.2/0.8~~ **2.2/0.8**, should be explicit, e.g., S/Steel Pillar Plate, Steel plug, Brass plug, Bolt, G.I. Pipe
- Description of mark..... should be explicit, e.g., S/Steel Pillar Plate, Steel plug, Brass plug, Bolt, G.I. Pipe
- Height of mark.....m. above rock/concrete; Mark is.....m. above G.L.
- Height of Top Vanes to Top Mark/~~Bottom plate~~ ~~2.2/0.8~~ **2.2/0.8**.....m. Diameter of Vanes (vertical) **0.6/0.8**.....m.
- Height of Cairn.....m. Diameter of Cairn.....m. Name Plate found/~~not found~~/~~replaced~~.
- Length of Mast.....m. (approximate if not unplied)
- A.....set in conc/rock has been placed/found, bearing.....° M from Mast/Plug/Pillar
 - A.....set in conc/rock has been placed/found, bearing.....° M from Mast/Plug/Pillar
 - A.....set in conc/rock has been placed/found, bearing.....° M from Mast/Plug/Pillar
 - A.....set in conc/rock has been placed/found, bearing.....° M from Mast/Plug/Pillar
8. Action required:.....

STANDPOINT:			
Mark	Direction	Horiz. Distance	Height Difference
			above standpt.
			below standpt.
			above standpt.
			below standpt.
Prepared by: *[Signature]* Checked: *[Signature]* 23/8/79 Noted on U.T.M. Card

6: 2723--2 D. West, Government Printer

STATION **ROUND TS 3789**

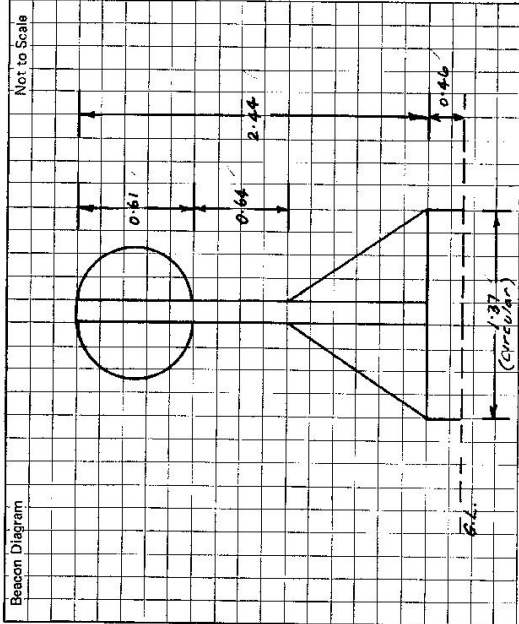

Owner's Name: *DEPT OF Education*
 Address:
 Phone:

Current Occupant:
 Address:
 Phone:

ACCESS
 Access Report of *27.8.1978* was found suitable/unsuitable.

*Station is located in grounds of
 KURMOND PUBLIC SCHOOL
 Principal: Mr. Manning*

This section to be completed by officer constructing pillar.

Original station mark found/not found.

Description of mark:

Original beacon found/not found.

Description of beacon:

Height Top of Vanes to Top Mark:m.

Height of mark:m. above
 rock/concm. below G.L.

Diameter of Vanesm. Height of Cairnm.

Original Beacon has/has not been destroyed by me.

Date

Record of Station