

7-6-193

Department of Lands

in the name of N.S.W.

RECONNAISSANCE and MAINTENANCE REPORT 2519G

STATION PRESIDENT

TS 3796

Note: Cross out word or words which do not apply

This Trig. Station has been

1. Completely cleared to permit 360° vision to surrounding Trigs.

2. Cleared by lanes bearing from Trig. Mast

Map Sheet: No:

Inspected by: Date:

Authority: Field Book:

Beacon Diagram Not to Scale

ABSTRACT OF OBSERVATIONS

To	R.L. (metres)	Direction or Vert. Angle	Variation	Observer	Date	Dist. in metres at M.S.L.	Inst.	Observer	Date
<p>STATION PRESIDENT (Grade) R.L. 83.56 (7.96 obs) meters</p> <p>See Reverse for Beacon Diagram</p> <p>July 11, 25th Jan 1974</p> <p>R.L. 83.56m (see back Station) Top Obs. Plate</p>									

All directions corrected to centre

C 13

All Vert's corrected ground to ground

SEE REAR OF CARD FOR REMARKS

13. v.m. m. is m. Below

14. Diff. Ht. is m. above below

15. Diff. Ht. is m. above below

16. Diff. Ht. is m. above below


Prepared by:

Checked:


Date

11/11 C. Smeesley. Pillar details unchanged

Record of Station
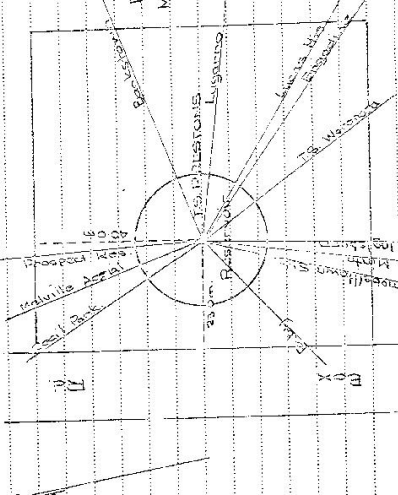
<p style="text-align: center;">STATION</p> <p style="text-align: center;">PRESTONS (P) 3796</p>	<p>Current Occupant:</p> <p>Address:</p>
<p>Owners Name:</p> <p>Address:</p>	<p>Access:</p>
<p style="text-align: center;">PRESTONS RES (centre)</p>	
<p>Remarks</p> 	

Station Diagram

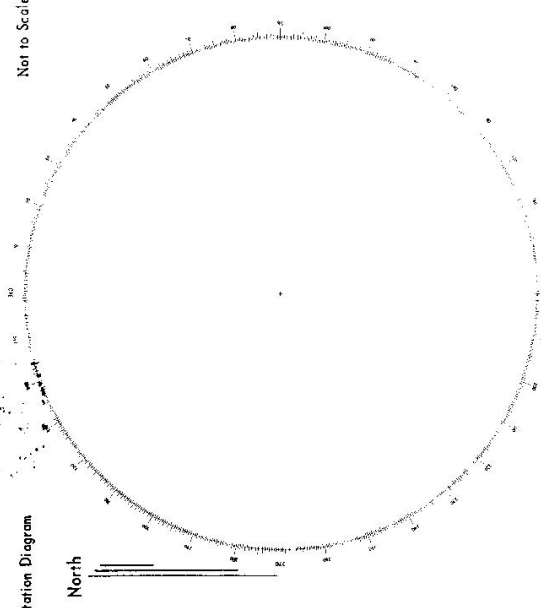

Not to Scale

List of Observed Directions:—

Standpoint:		Station:	
Station	Direction	Station	Direction

Station	Direction	Station	Direction