

**LAND INFORMATION CENTRE**

GEODETIC SURVEY OF N.S.W.

**GEODETIC STATION RECONNAISSANCE and MAINTENANCE REPORT**

STATION: **PRICE (P)** No.: **3795**

MAP SHEET SCALE 1:250 000

**NEWCASTLE**

INSPECTED BY: **S Gwynor**

DATE: **6-1-87**

AUTHORITY: **LIC**

FIELD BOOK: **526**

- Description:
1. Cleared by lanes bearing..... Note: Cross out word or words which do not apply
  2. Mast & Vanes have been painted white & black respectively. .... from Trig, Mast
  3. The station/pillar was unpiled/not unpiled/constructed on..... 19....., dimensions now being:


Description of mark..... should be explicit, e.g., S/Steel Pillar Plate, Steel plug, Brass plug, Bolt, G.I. Pipe

STANDPOINT: **Cu. Nail - 3**      STANDPOINT: **SSM - 2**

Mark	Direction	Horiz. Distance	Height Difference	Mark	Direction	Horiz. Distance	Height Difference
<b>Black Hill Spur (P)</b>	<b>0 00 00</b>			<b>Black Hill Sp (P)</b>	<b>0 00 00</b>		
<b>Trig Plug</b>	<b>5 03 30</b>	<b>3.662</b>	<b>0.076</b>	<b>Spike</b>	<b>116 22 14</b>	<b>19.640</b>	<b>0.112</b>
<b>SSM</b>	<b>42 08 15</b>	<b>4.822</b>	<b>0.236</b>	<b>(P)</b>	<b>194 46 20</b>	<b>2.435</b>	<b>1.267</b>
<b>(P)</b>	<b>64 57 33</b>	<b>2.890</b>	<b>1.500</b>	<b>Cu. Nail</b>	<b>222 12 09</b>	<b>4.829</b>	<b>0.232</b>
<b>Spike</b>	<b>103 51 22</b>	<b>21.462</b>	<b>0.121</b>	<b>Wrench (P)</b>	<b>265 05 09</b>		
<b>Munibung (P)</b>	<b>289 16 22</b>			<b>Plug</b>	<b>271 22 55</b>	<b>2.916</b>	<b>0.309</b>
<b>Great Sg ABC 5</b>	<b>337 08 14</b>	<b>-5</b>		<b>Munibung (P)</b>	<b>289 16 16</b>		
				<b>Great Sg ABC 5</b>	<b>337 08 32</b>		

STANDPOINT: **Cone (P)**      STANDPOINT: **Trig Plug - 1**

Mark	Direction	Horiz. Distance	Height Difference	Mark	Direction	Horiz. Distance	Height Difference
<b>Black Hill Spur (P)</b>	<b>0 00 00</b>			<b>Black Hill Spur (P)</b>	<b>0 00 00</b>		
<b>SSM</b>	<b>14 43 10</b>	<b>2.434</b>	<b>1.266</b>	<b>SSM</b>	<b>91 25 10</b>	<b>2.915</b>	<b>0.313</b>
<b>Spike</b>	<b>109 16 11</b>	<b>19.299</b>	<b>1.382</b>	<b>Spike</b>	<b>113 11 05</b>	<b>22.318</b>	<b>0.198</b>
<b>Cu. Nail</b>	<b>245 00 02</b>	<b>2.894</b>	<b>1.501</b>	<b>(P)</b>	<b>136 33 18</b>	<b>3.339</b>	<b>1.577</b>
<b>Munibung (P)</b>	<b>289 16 42</b>			<b>Cu. Nail</b>	<b>185 06 21</b>	<b>3.662</b>	<b>0.079</b>
<b>Trig Plug</b>	<b>316 35 11</b>	<b>3.337</b>	<b>1.576</b>	<b>Wrench (P)</b>	<b>245 03 07</b>		
<b>Great Sg ABC-5</b>	<b>337 08 33</b>	<b>-5</b>		<b>Munibung (P)</b>	<b>289 15 13</b>		
				<b>Great Sg ABC-5</b>	<b>337 07 54</b>		

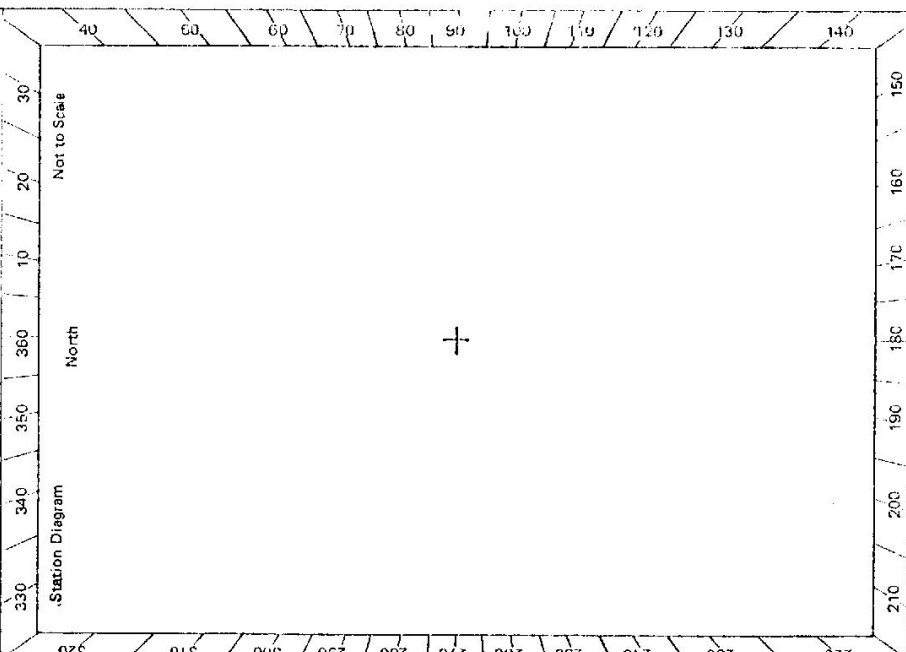

Checked

Noted on U.T.M. Card

Checked: (LIC)

Prepared by: **Blair**

GEODETTIC SURVEY OF M.S.W.

CENTRAL MAPPING AUTHORITY


GEODETTIC STATION RECONNAISSANCE and MAINTENANCE REPORT

STATION: Price Pillar No.: TS 3798

MAP SHEET SCALE 1:250 000 NEWCASTLE

INSPECTED BY: D. Kain DATE: 18.1.1990

AUTHORITY: L.I.C. FIELD BOOK: C00511

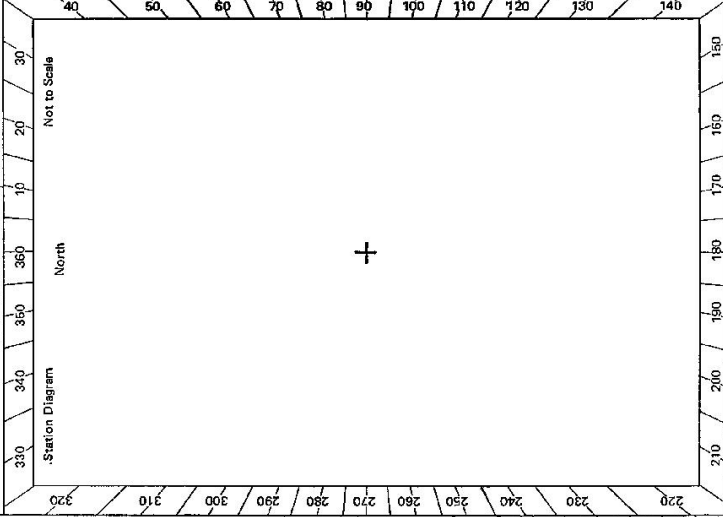

Description:

1. Cleared by lanes bearing 450.0 M. Elev. 17.0 <sup>7.0</sup> 2.1 Elev. from Trig. Mast  
 2. Mast & Vanes have been painted white & black respectively. 136 M. 76 Elev.

3. The station/pillar was unpiled/hot unpiled/constructed on 19 dimensions now being:

Description of mark above should be explicit, e.g., S/Steel Pillar/Plate, Steel plug, Brass plug, Bolt, G.I. Pipe

Height of mark above rock/concrete; Mark is <sup>above</sup> below G.I.

Height of Top Vanes to Top Mark/Pillar plate above below Diameter of Vanes (vertical) below m.

Height of Cairn above below Diameter of Cairn below m. Name Plate found/not found/placed.

Length of Mast above below m. (approximate if not unpiled)

4. A set in conc/rock has been placed/found, bearing 0 M from Mast/Plug/Pillar

5. A set in conc/rock has been placed/found, bearing 0 M from Mast/Plug/Pillar

6. A set in conc/rock has been placed/found, bearing 0 M from Mast/Plug/Pillar

7. A set in conc/rock has been placed/found, bearing 0 M from Mast/Plug/Pillar

8. Action required: .....

STANDPOINT:			
Mark	Direction	Horiz. Distance	Height Difference
			above standpt.
			below standpt.
			above standpt.
			below standpt.
Prepared by: ..... Checked: .....

S: 2733-1 Noted on U.T.M. Card

GS 24

STATION	PRICE PILLAR TS 3718	
Beacon Diagram 	Owner's Name: ..... Address: ..... Phone: ..... Current Occupant: ..... Address: ..... Phone: .....	<p>NO PREVIOUS ACCESS AVAILABLE.                      ACCESS Report of ...../19..... was found suitable/unavailable.                      FEATURE</p> <p>0.00 AT ROAD INTERSECTION OF PACIFIC HIGHWAY                      AND WALLSEND ROADS AT SANDGATE, TRAVEL TOWARD                      HEXHAM</p> <p>1.24 TURN LEFT ONTO SEALDEN ROAD, ST. JOSEPHS                      HOME TRADES ENTRANCE.</p> <p>1.31 PASS CONCRETE PLANT ON YOUR L.H.S.</p> <p>1.70 PILLAR IS SITUATED ON WESTERN SIDE OF 2 HD                      RADIO AERIAL.</p>
This section to be completed by officer constructing pillar. Original station mark found/not found. Description of mark: ..... Original beacon found/not found. Description of beacon: ..... Height Top of Vanes to Top Mark .....m. Height of mark .....m. above G.L. below rock/conc .....m. below Diameter of Vanes .....m. Height of Cairn .....m. Original Beacon has/has not been destroyed by me.	Date ..... Record of Station .....	