

CENTRAL MAPPING AUTHORITY

GEODETIC SURVEY OF N.S.W.

GEODETIC STATION RECONNAISSANCE and MAINTENANCE REPORT

Description:

Note: Cross out word or words which do not apply

1. Cleared by lanes bearing..... from Trig. Mast
2. Mast & Vanes have been painted white & black respectively.
3. The station/pillar was unpiled/not unpiled/constructed on.....19....., dimensions now being:
Description of mark.....should be explicit, e.g., S/Steel Pillar Plate, Steel plug, Brass plug, Bolt, G.I. Pipe
Height of mark.....m. ^{above} rock/concrete; Mark is.....m. ^{above} _{below} G.L.
Height of Top Vanes to Top Mark/Pillar platem. Diameter of Vanes (vertical).....m.
Height of Cairn.....m. Diameter of Cairn.....m. Name Plate found/not found/placed.
Length of Mast.....m. (approximate if not unpiled)
4. A.....set in conc/rock has been placed/found, bearing.....°M from Mast/Plug/Pillar
5. A.....set in conc/rock has been placed/found, bearing.....°M from Mast/Plug/Pillar
6. A.....set in conc/rock has been placed/found, bearing.....°M from Mast/Plug/Pillar
7. A.....set in conc/rock has been placed/found, bearing.....°M from Mast/Plug/Pillar
8. Action required:.....

STANDPOINT:

STANDPOINT:

Mark	Direction	Horiz. Distance	Height Difference	Mark	Direction	Horiz. Distance	Height Difference
			above standpt.				above standpt.
			below standpt.				below standpt.
			above standpt.				above standpt.
			below standpt.				below standpt.
Prepared by: *[Signature]*

Checked: *[Signature]*

Noted on U.T.M. Card

ST 2733-1

Checked

STATION: **PULPIT** No.: **3807**

MAP SHEET: **WAGGA WAGGA** 1:100 000 SCALE

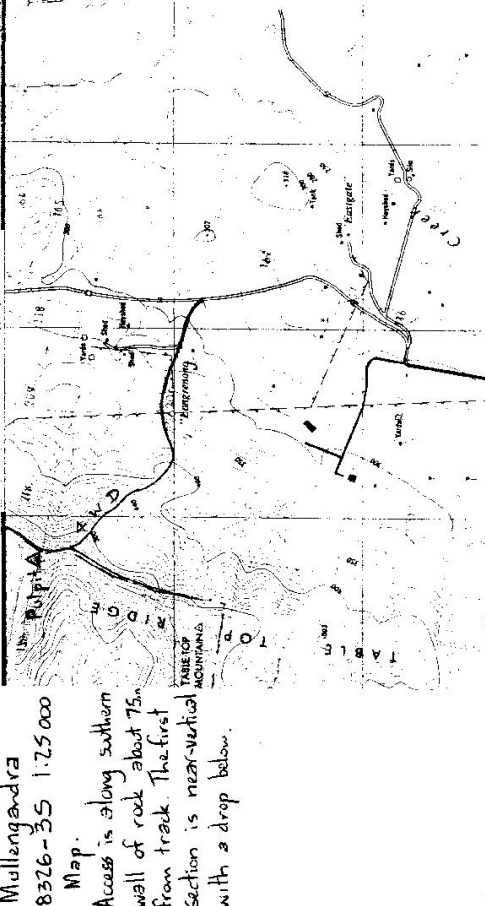
INSPECTED BY: **J. SUTTON** HDL BOOK

AUTHORITY: **CMA** DATE: **20 Feb 1989**

FIELD BOOK: **-**

Station Diagram

Not to Scale

St 2733-2 D. West, Government Printer Beacon Diagram	STATION PULPIT TS 3807	Owner's Name: Address: Phone:	Current Occupant: Address: Phone:	<p style="text-align: center;">ACCESS</p> <p>See Access Report of 22/2/1982 was found suitable/unsuitable. Mullengandya 8326-35 1:25 000 Map. Access is along southern wall of rock about 75m from track. The first section is near-vertical with a drop below.</p> 	Record of Station
Not to Scale				Date	Record of Station
This section to be completed by officer constructing pillar. Original station mark found/not found. Description of mark: Original beacon found/not found. Description of beacon: Height Top of Vanes to Top Markm. Height of markm. above G.L. below Diameter of Vanesm. Height of Cairnm. Original Beacon has/has not been destroyed by me.				Record of Station	