

CENTRAL MAPPING AUTHORITY

GEODETIC SURVEY OF N.S.W.

GEODETIC STATION RECONNAISSANCE and MAINTENANCE REPORT

STATION: QUIDONG No.: 3827

Description:

1. Cleared by lanes bearing.....
Note: Cross out word or words which do not apply

2. Mast & Vanes have been painted white & black respectively.
 The station/pillar was unpiled/not unpiled/constructed on..... from Trig. Mast

3. Description of mark..... should be explicit, e.g. S/Steel Pillar Plate, Steel plug, Brass plug, Bolt, G.I. Pipe
 Height of mark.....m. ^{above} rock/concrete; Mark is.....m. ^{above} G.L.
 Height of Top Vanes to Top Mark/Pillar plate.....m. Diameter of Vanes (vertical).....m.
 Height of Cairn.....m. Diameter of Cairn.....m. Name Plate found/not found/placed.
 Length of Mast.....m. (approximate if not unpiled)

4. A..... set in conc/rock has been placed/found, bearing.....°M from Mast/Plug/Pillar

5. A..... set in conc/rock has been placed/found, bearing.....°M from Mast/Plug/Pillar

6. A..... set in conc/rock has been placed/found, bearing.....°M from Mast/Plug/Pillar

7. A..... set in conc/rock has been placed/found, bearing.....°M from Mast/Plug/Pillar

8. Action required:.....


MAP SHEET SCALE 1:250 000

INSPECTED BY: G. C. HANNA

DATE: 28 - 4 - 80

AUTHORITY: C. M. A.

FIELD BOOK:

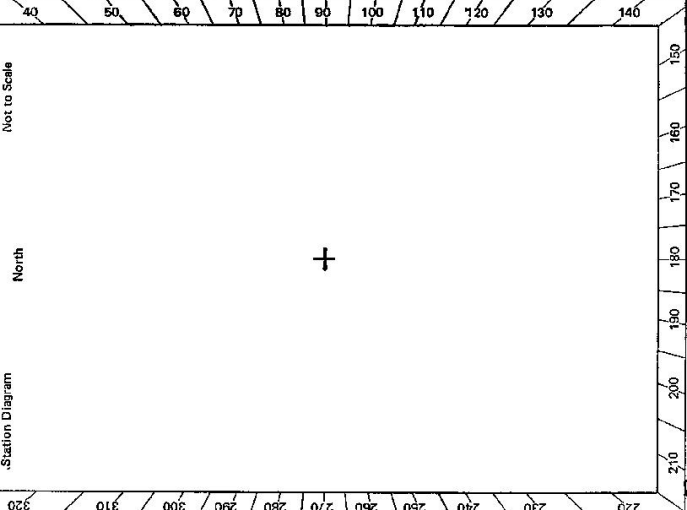

STANDPOINT:

Mark	Direction	Horiz. Distance	Height Difference	Mark	Direction	Horiz. Distance	Height Difference
			above standpt				above standpt
			below				below
			above standpt				above standpt
			below				below
Prepared by: G. Hanna 8-5-80 Checked: G. Hanna 29/6/80

Station still checked

GS 24

Beacon Diagram Not to Scale 	STATION QUIDONG TS 3827	<p> Owner's Name: <u>MR. INGRAM</u> Address: <u>HILLCREST</u> Phone: <u>Via Tombong</u> </p> <p> Current Occupant: Address: Phone: </p> <p> As reported by owner of "Hillcrest" who visited trig October 1979. C.M & V confirmed. M&V in need of paint. Light clearing required. 15 - 20 minute to trig. </p> <p> <u>ACCESS</u> Access Report of <u>28/4/1980</u> was found suitable/unavailable. </p> <p> <u>ACCESS</u> See also Tombong 8624 - S </p> <p> Km 0.0 Delegate P.O. towards Victoria. 0.7 R.H. turn towards Currawong/Tombong. 9.6 R.H. turn towards Tombong. 18.2 R.H. turn. 18.95 "Hillcrest" homestead. 19.05 Take track to right 19.2 Gate beside woolshed. 19.6 Track veers to right. 19.8 Track veers to right Gates at 19.92, 20.3, 21.1, 21.6. 22.95 Gate. 22.95 L.H. turn off track & follow fence. 23.1 Stop beside fence & follow ridge to trig. </p>
This section to be completed by officer constructing pillar. Original station mark found/not found.		Record of Station
Description of mark: Original beacon found/not found. Description of beacon: Height Top of Vanes to Top Mark.....m. Height of mark.....m. above G.L. below Diameter of Vanesm. Height of Cairnm. Original Beacon has/has not been destroyed by me.		Date