

7-4-88

CENTRAL MAPPING AUTHORITY

Trigonometrical Survey of N.S.W.

Department of Lands

RECONNAISSANCE and MAINTENANCE REPORT

STATION TS 3832 QU ROBO LONG (P)

This Trig. Station has been:-

Note: Cross out word or words which do not apply

1. ~~Completely cleared to permit 360° vision to surrounding Trigs.~~

2. Cleared by lanes bearing from 260° M to 20° M

3. Trig. Mast & Vanes have been painted white & black respectively.

4. The Trig. was unpiled/not unpiled, dimensions now being:

Description of mark..... should be explicit, e.g. Steel plug, Brass plug, Bolt, G.I. Pipe

Height of mark..... m above rock/concrete..... m below G.L.

Height of Top Vanes to Top Mark..... m. Diameter of Vanes (vertical)..... m.

Height of Cairn..... m. Diameter of Cairn..... m.

Length of Mast..... m. (approximate if not unpiled)

5. A..... set in conc/rock has been placed..... m. bearing..... °M from Trig. Mast

6. A..... set in conc/soil has been placed..... m. bearing..... °M from Trig. Mast

7. A..... set in conc/soil has been placed..... m. bearing..... °M from Trig. Mast

8. A..... set in conc/rock has been placed..... m. bearing..... °M from Trig. Mast

9. Connection..... to..... m. bearing..... °M

10. Connection..... to..... m. bearing..... °M

11. Connection..... to..... m. bearing..... °M

12. Connection..... to..... m. bearing..... °M

13. Diff. Ht. is..... m. above below

14. Diff. Ht. is..... m. above below

15. Diff. Ht. is..... m. above below

16. Diff. Ht. is..... m. above below

Prepared by: P. O'Kane


Checked:

Noted on U.T.M. Card

Checked

Co. Northumberland Ph: QUORROBOLONG
 Map Sheet: QUORROBOLONG No. 1 56-1 JD 48
 Inspected by: P. O'Kane Date: 10-5-90
 Authority: SOB Newcastle Field Book:

Beacon Diagram Not to Scale

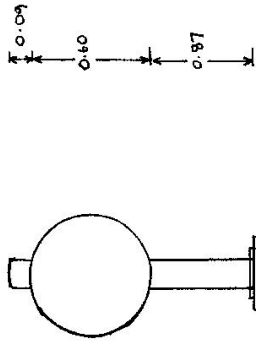

Date Record of Station

5/90 New mast & vanes. They are only attached by 2 screws as one screw has been previously sheered off and could not be removed. Wide alley cleared.

25/07/98 10:14 @ 81 2 267 4942 SUB DWG ... NECASTLE OKAN 001.001

ACCESS DIAGRAM

00	Mulbering P.O at Stone and Vincent st's Head South on Vincent St
0.15	Turn right into Child St
0.35	Turn Left into Palmer St
0.9	Turn Left into main road to Toronto
1.8	Turn right into Sandy Creek Rd
8.8	Pass Wollong Rd on Right
11.4	Turn Left onto Heaton Rd "Matagan Forest Road Sign"
15.0	Grid, onto dirt road.
16.3	Grid
16.9	Turn right onto Georges Road
17.6	Turn right through locked gate "Johnston"
18.5	House AND SHACKS - DOGS HOSTILE
19.3	T.S QUORROBOLONG.

3832 STATION QUORROBOLONG (P)

PROVISIONAL VALUES

AUSTRALIAN MAT GRID	INTEGRATED SURVEYS GRID
METRES CM.	METRES CM.
ZONE E	ZONE E
Provisional Height	m(A.H.I.D.) Agency

HISTORY OF STATION

Date	Record of Field Action, Marking, and Description of Station	Reference
3/98	<p>AVOID Access ; Some Fallen trees to cross dirt roads</p> <p>Pass through PRIVATE LAND "FOUR HORIZONS"</p> <p>OWNER : MR LINDSAY JOHNSTON</p> <p>PHONE : 49986257</p> <p>MOBILE : 019455649</p> <p>GRID IS ON FORESTRY COMMISSION LAND</p>	
3/28	TRAIL CLEARED FOR A.P.S.	NA