

CENTRAL MAPPING AUTHORITY

GEODETIC SURVEY OF N.S.W.


GEODETIC STATION RECONNAISSANCE and MAINTENANCE REPORT

STATION: RABBIT No.: 3833

MAP SHEET SCALE: 250 000 CRAFTON

INSPECTED BY: D. KINLYDE DATE: 16.8.78

AUTHORITY: CHA 67/2/2 FIELD BOOK: -

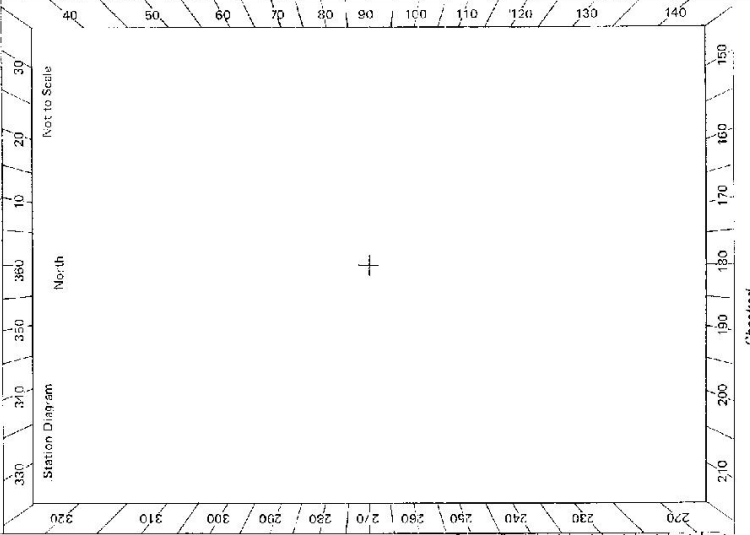

Description: *Note: Cross out word or words which do not apply*

1. Cleared by lanes bearing..... *not cleared*..... from Trig. Mast
2. Mast & Vanes have been painted white & black respectively.
3. The station/pillar was *not* unpiled/constructed *on*..... *to*....., dimensions now being: *beetle in conc.* should be explicit, e.g., S/Steel Pillar Plate, Steel plug, Brass plug, Bolt, G.I. Pipe
Description of mark..... *beetle in conc.* ^{above} _{below} G.L.
- Height of mark..... ^{above} _{below} rock/concrete; Mark is..... ^{above} _{below} G.L.
- Height of Top Vanes to Top Mark/Pillar plate.....m. Diameter of Vanes (vertical).....m.
- Height of Cairn.....m. Diameter of Cairn.....m. Name Plate found/not found/placed.
- Length of Mast.....m. (approximate if not unpiled)
4. A..... ^{above} _{below} set in conc./rock has been placed/found, bearing.....°M from Mast/Plug/Pillar } *no marks found*
5. A..... ^{above} _{below} set in conc./rock has been placed/found, bearing.....°M from Mast/Plug/Pillar }
6. A..... ^{above} _{below} set in conc./rock has been placed/found, bearing.....°M from Mast/Plug/Pillar
7. A..... ^{above} _{below} set in conc./rock has been placed/found, bearing.....°M from Mast/Plug/Pillar

8. Action required: *4 days clearing for 360° vision, suitable for conc. pillar*
1 day clearing for optimisation requirements (lanes on TS and 283 M)

STANDPOINT:			
Mark	Direction	Horiz. Distance	Height Difference
			above standpt.
			below standpt.
			above standpt.
			below standpt.
Prepared by: D. Kinlyde Checked: *A. Paterson 8/11/78* Noted on U.T.M. Card

GS


STATION **R.A.BBIT Ts 3833**

Owner's Name: **M. W. McINTOSH**
 Address: **C. LAUREVAUX**
 Phone: **CL. 0065 056**

Current Occupant:
 Address:
 Phone:

ACCESS

Access Report of 18.12.1971 was found suitable/unsuitable.

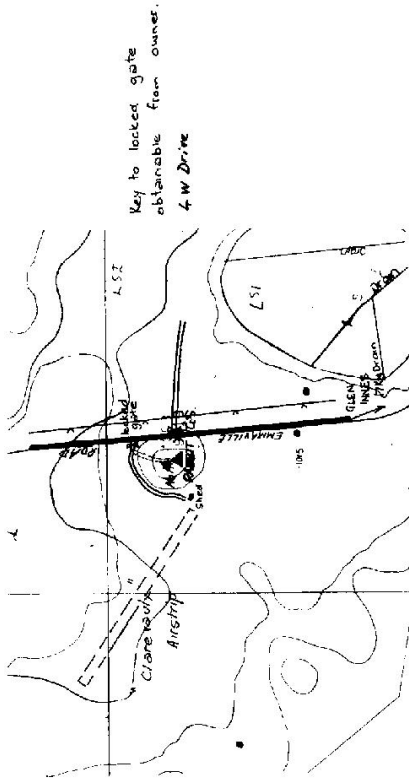

Beacon Diagram	Not to Scale
[Grid area for diagram]	

This section to be completed by officer constructing pillar.

Original station mark found/not found.

Description of mark:

Original beacon found/not found.

Description of beacon:

Height Top of Vanes to Top Markm.

Height of markm. above G.L. / below

Diameter of Vanesm. Height of Cairnm.

Original Beacon has/has not been destroyed by me.

Date	Record of Station