

CENTRAL MAPPING AUTHORITY      GEODETIC SURVEY OF N.S.W.      GEODETIC STATION RECONNAISSANCE and MAINTENANCE REPORT

STATION: **RAMSHEAD SOUTH GS** No.: **TS 3842**  
 MAP SHEET SCALE 1:250 000 **TALLANGATTA**  
 INSPECTED BY: **A WOODROFF** DATE: **8-2-77**  
 AUTHORITY: CENTRAL MAPPING AUTHORITY. FIELD BOOK: **1581**

**1. Cleared by lanes bearing**..... **360°**..... **VISION**..... from Trig. Mast  
*Note: Cross out word or words which do not apply*


**2. Mast & Vanes have been painted white & black respectively.**

**3. The station/pillar was unpiled/not unpiled/constructed on**..... **19**....., dimensions now being:  
 Description of mark..... **PILG**..... should be explicit, e.g., S/Steel Pillar Plate, Steel plug, Brass plug, Bolt, G.I. Pipe  
 Height of mark..... **3.54**..... m. <sup>above</sup> **rock/concrete**; Mark is..... m. <sup>above</sup> **G.L.**  
 Height of Top Vanes to Top Mark/Pillar plate..... **3.54**..... m. Diameter of Vanes (vertical)..... m.  
 Height of Cairn..... m. Diameter of Cairn..... m. Name Plate found/not found/placed.  
 Length of Mast..... **1.54**..... m. (approximate if not unpiled)

**4. A..... G.I. PIPER..... set in conc/rock has been placed/ found, bearing.....° M from Mast/Plug/Pillar**  
**5. A..... set in conc/rock has been placed/ found, bearing.....° M from Mast/Plug/Pillar**  
**6. A..... set in conc/rock has been placed/ found, bearing.....° M from Mast/Plug/Pillar**  
**7. A..... set in conc/rock has been placed/ found, bearing.....° M from Mast/Plug/Pillar**  
**8. Action required:**.....

STANDPOINT: <b>TRIG PLUG</b>				STANDPOINT:			
Mark	Direction	Horiz. Distance	Height Difference	Mark	Direct on	Horiz. Distance	Height Difference
<b>GPIPE</b>	<b>95M</b>	<b>48.0</b> <del>48.0</del>	<b>23.58</b> <del>23.58</del>				
			above standpt.				above standpt.
			below standpt.				below standpt.
			above standpt.				above standpt.
			below standpt.				below standpt.
			above standpt.				above standpt.
			below standpt.				below standpt.
			above standpt.				above standpt.
			below standpt.				below standpt.

Prepared by: **A. Woodroff**      Checked: **[Signature]**      Noted on U.T.M. Card

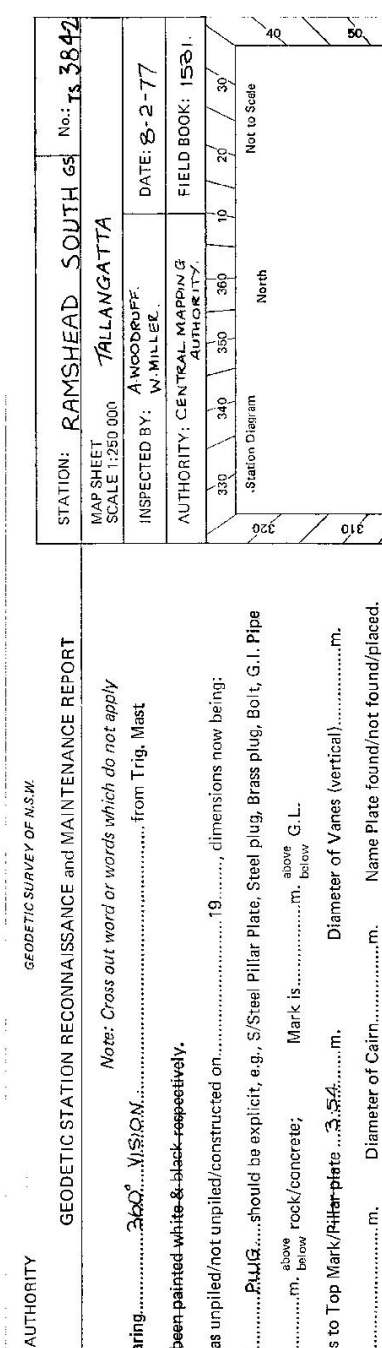

STATION: **RAMSHEAD SOUTH GS** No.: **TS 3842**  
 MAP SHEET SCALE 1:250 000 **TALLANGATTA**  
 INSPECTED BY: **A WOODROFF** DATE: **8-2-77**  
 AUTHORITY: CENTRAL MAPPING AUTHORITY. FIELD BOOK: **1581**

ST 2753-1

CENTRAL MAPPING AUTHORITY GEODETTIC SURVEY OF N.S.W.

GEODETTIC STATION RECONNAISSANCE and MAINTENANCE REPORT

Note: Cross out word or words which do not apply

STATION: SOUTH RAMSHEADS No.: TS 3842  
 MAP SHEET THREE 60 8524 - N 1:50000  
 SCALE 1:250 000 TRILANGGATA SJ/55-3  
 INSPECTED BY: J. SHERWIN DATE: 23/2/80  
 AUTHORITY: CMA FIELD BOOK:

1. Cleared by lanes bearing..... from Trig. Mast

2. Mast & Vanes have been painted white & black respectively.

3. The station/pillar was unpiled/not unpiled/constructed on..... 19....., dimensions now being:  
 Description of mark..... should be explicit, e.g., S/Steel Pillar Plate, Steel plug, Brass plug, Bolt, G.I. Pipe  
 Height of mark.....<sup>above</sup>.....<sup>below</sup>.....m. Mark is.....<sup>above</sup>.....<sup>below</sup>.....m. G.L.  
 Height of Top Vanes to Top Mark/Pillar plate.....m. Diameter of Vanes (vertical).....m.  
 Height of Cairn.....m. Diameter of Cairn.....m. Name Plate found/not found/placed.  
 Length of Mast.....m. (approximate if not unpiled)

4. A..... set in conc/rock has been placed/found, bearing.....° M from Mast/Plug/Pillar

5. A..... set in conc/rock has been placed/found, bearing.....° M from Mast/Plug/Pillar


6. A..... set in conc/rock has been placed/found, bearing.....° M from Mast/Plug/Pillar

7. A..... set in conc/rock has been placed/found, bearing.....° M from Mast/Plug/Pillar

8. Action required:.....

STANDPOINT:			
Mark	Direction	Horiz. Distance	Height Difference
			above standpt.
			below standpt.
			above standpt.
			below standpt.
Prepared by: ..... Checked: .....  
 Noted on U.T.M. Card

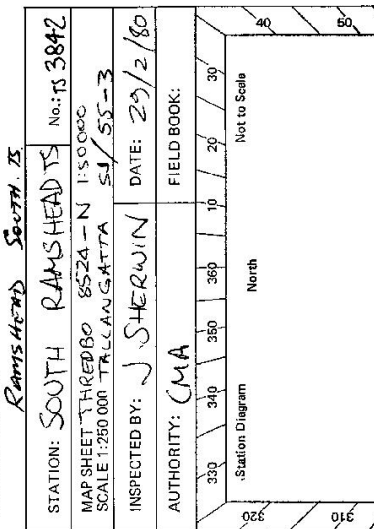


STATION SOUTH RAMSHEAD T.S. 3842

Owner's Name: KNP  
 Address: .....  
 Phone: .....  
 Current Occupant: .....  
 Address: .....  
 Phone: .....

Access Report of 29/1/1988 was found suitable/unsuitable.  
 ACCESS

SEEN FROM THE AIR  
 2km WEST OF DEAD HORSE GAP ON THE ALPINE  
 WAY WALK NORTH UP RIDGE TO TRIG.

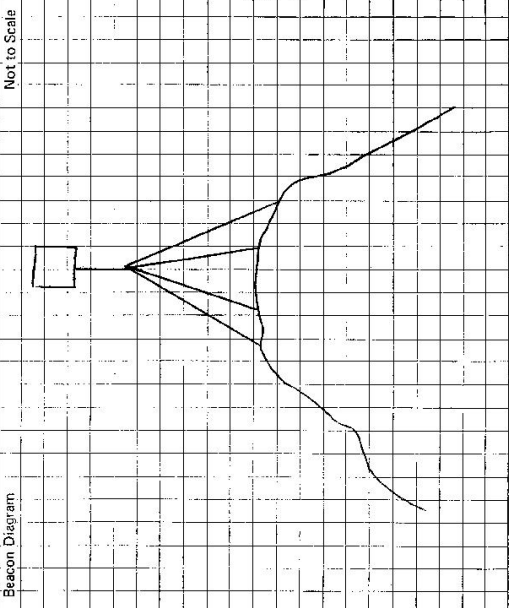

This section to be completed by officer constructing pillar.  
 Original station mark found/not found.  
 Description of mark: .....  
 Original beacon found/not found.  
 Description of beacon: .....  
 Height Top of Vanes to Top Mark: .....m.  
 Height of mark: .....m. above G.L. below  
 Diameter of Vanes .....m. Height of Cairn .....m.  
 Original Beacon has/has not been destroyed by me.

Date	Record of Station

G

<p>STATION <b>RAMSHEAD SOUTH TS 3842</b></p>	<p>Owner's Name: <b>MARSHALLS NATIONAL PARK</b>                  Current Occupant: .....                  Address: .....                  Phone: .....</p> <p style="text-align: center;"><b>ACCESS</b></p> <p>Access Report of <b>8.2.1977</b> was found suitable/unsuitable.                  Refer to Jacobs River 1:100,000 from Dead Horse Gap                  which is about 4kms from Thredbo towards Klancoban.                  LEAVE vehicle in parking area and walk 200m up sealed                  road towards Klancoban. Walk off road to right                  and try to follow ridge up to the Trig Station.                  If at least an hours walk with gear.</p>										
<p>Beacon Diagram</p>	<p style="text-align: right;">Not to Scale</p> <p>This section to be completed by officer constructing pillar.</p> <p>Original station mark found/not found. ....</p> <p>Description of mark: .....</p> <p>Original beacon found/not found. ....</p> <p>Description of beacon: .....</p> <p>Height Top of Vanes to Top Mark ..... m.                  above below                  Height of mark ..... m. rock/cont. .... m. above below G.L.                  Diameter of Vanes ..... m. Height of Cairn ..... m.                  Original Beacon has/has not been destroyed by me. ....</p>										
	<table border="1" style="width: 100%; border-collapse: collapse;"> <tr> <td style="width: 50%;">Date</td> <td style="width: 50%;">Record of Station</td> </tr> <tr> <td> </td> <td> </td> </tr> <tr> <td> </td> <td> </td> </tr> <tr> <td> </td> <td> </td> </tr> <tr> <td> </td> <td> </td> </tr> </table>	Date	Record of Station								
Date	Record of Station										