

GEODETTIC SURVEY OF N.S.W.

CENTRAL MAPPING AUTHORITY


GEODETTIC STATION RECONNAISSANCE and MAINTENANCE REPORT

STATION: RANKIN No.: TS 3848

MAP SHEET SCALE 1:250 000 Goulburn

INSPECTED BY: A. Sivertsen DATE: 30-10-78

AUTHORITY: CMA FIELD BOOK: 1709

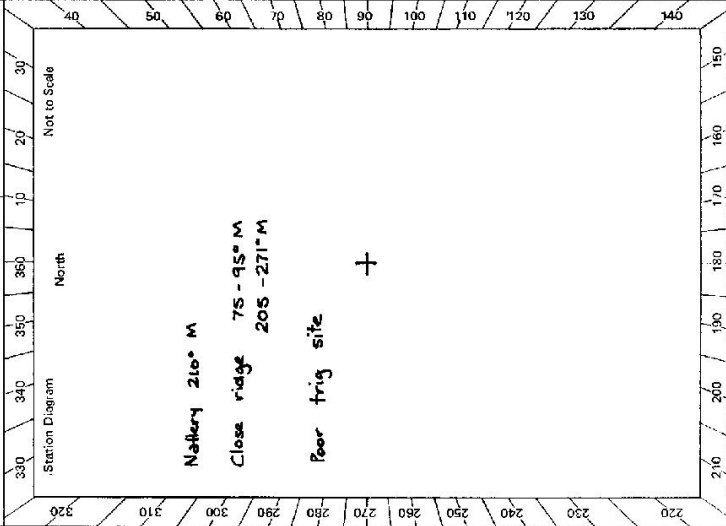

- Description: *Note: Cross out word or words which do not apply*
- Cleared by lanes bearing..... cleared 360..... from Trig. Mast
 - Mast & Vanes have been painted white & black respectively. Beacon in fair condition
 - The station ~~is in a fair condition~~ not unpiled/empty/empty on..... 19....., dimensions now being: Description of mark..... should be explicit, e.g., S/Steel Pillar Plate, Steel plug, Brass plug, Bolt, G.I. Pipe
 - Height of mark..... m. ^{above} rock/concrete; Mark is..... m. ^{above} G.L.
 - Height of Top Vanes to Top ~~Mark~~ Cairn..... m. Diameter of Vanes (vertical)..... 0.6 m.
 - Height of Cairn..... 0.5 m. Diameter of Cairn..... 2 m. Name Plate ~~found~~ not found
 - Length of Mast..... m. (approximate if not unpiled)
 - A..... set in conc/rock has been placed/round, bearing..... M from Mast/Plug/Pillar
 - A..... set in conc/rock has been placed/round, bearing..... M from Mast/Plug/Pillar
 - A..... set in conc/rock has been placed/round, bearing..... M from Mast/Plug/Pillar
 - A..... set in conc/rock has been placed/round, bearing..... M from Mast/Plug/Pillar
 - Action required:..... TOWRANG

STANDPOINT: 1:25,000

Mark	Direction	Horiz. Distance	Height Difference	Mark	Direction	Horiz. Distance	Height Difference
			above standpt.				above standpt.
			below				below
			above standpt.				above standpt.
			below				below
Prepared by: *[Signature]* Checked: *[Signature]* Noted on U.T.M. Card


STATION **RANKIN TS 3848**

Owner's Name:
 Address:
 Phone:
 Current Occupant:
 Address:
 Phone:

ACCESS

Access Report of ~~2019~~ ^{19/18} was found suitable/unsuitable.

- 0.0 Goulburn P.O. Take Hwy north
- 7.2 Pass road on L
- 10.7 Pass TOWERANG road on L
- 11.5 Take road to L
- 14.3 Pass road on R
- 17.8 Pass road on L
- 18.0 Take gate on R
- 18.6 Gate then straight ahead.
- 18.8 Pass gate on R
- 19.1 Gate
- 19.55 Turn L off track towards gate
- 19.7 Gate. Make own way to Δ on next spur

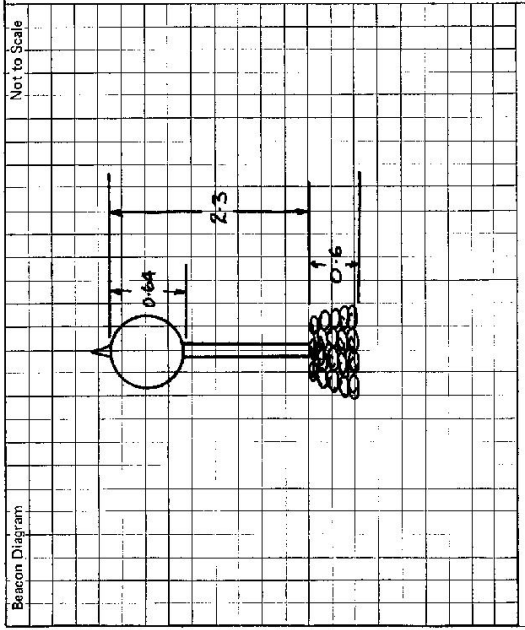

This section to be completed by officer constructing pillar.

Original station mark found/not found.

Description of mark:

Original beacon found/not found.

Description of beacon:

Height Top of Vanes to Top Mark.....m.

Height of mark.....ft. above / below rock/conc.....m. above / below G.L.

Diameter of Vanes.....m. Height of Cairn.....m.

Original Beacon has/hes not been destroyed by me.

Date	Record of Station

CENTRAL MAPPING AUTHORITY

GEODETIC SURVEY OF N.S.W.

GEODETIC STATION RECONNAISSANCE and MAINTENANCE REPORT

Description:

Note: Cross out word or words which do not apply

1. Cleared by lanes bearing..... from Trig. Mast
2. Mast & Vanes have been painted white & black respectively.
3. The station/pillar was unpiled/not unpiled/constructed on..... 19....., dimensions now being:
Description of mark.....should be explicit, e.g., S/Steel Pillar Plate, Steel plug, Brass plug, Bolt, G.I. Pipe
Height of mark.....m. ^{above} rock/concrete; Mark is.....m. ^{above} G.L.
- Height of Top Vanes to Top Mark/Pillar plate.....m. Diameter of Vanes (vertical).....m.
- Height of Cairn.....m. Diameter of Cairn.....m. Name Plate found/not found/placed.
- Length of Mast.....m. (approximate if not unpiled)
4. A.....set in conc/rock has been placed/found, bearing.....°M from Mast/Plug/Pillar
5. A.....set in conc/rock has been placed/found, bearing.....°M from Mast/Plug/Pillar
6. A.....set in conc/rock has been placed/found, bearing.....°M from Mast/Plug/Pillar
7. A.....set in conc/rock has been placed/found, bearing.....°M from Mast/Plug/Pillar
8. Action required:.....

STANDPOINT:

STANDPOINT:

Mark	Direction	Horiz. Distance	Height Difference	Mark	Direction	Horiz. Distance	Height Difference
			above standpt.				above standpt.
			below				below
			above standpt.				above standpt.
			below				below
Prepared by: Michael Clark 13.5.91 Checked: KJ

Noted on U.T.M. Card

S: 2733-1

STATION: RANKIN No: 3848

MAP SHEET SCALE 1:250 000 Goulburn

INSPECTED BY: M. CLARK DATE: 10-4-81

AUTHORITY: C.M.A. FIELD BOOK:

Station Diagram

Not to Scale

13.5.85 Checked

