

CENTRAL MAPPING AUTHORITY

GEODETIC SURVEY OF N.S.W.

GEODETIC STATION RECONNAISSANCE and MAINTENANCE REPORT

STATION: S M A 435 No: 385

MAP SHEET SCALE 1:250 000 CAN/BE RRA

INSPECTED BY: K. HADJOSK DATE: 14/01/1979

AUTHORITY: C.M.A. FIELD BOOK:

Description: *Note: Cross out word or words which do not apply*

- 1. Cleared by lanes bearing..... from Trig. Mast
- 2. Mast & Vanes have been painted white & black respectively.
- 3. The station/pillar was unpiled/not unpiled/constructed on..... dimensions now being: Description of mark..... should be explicit, e.g., S/Steel Pillar Plate, Steel plug, Brass plug, Bolt, G.I. Pipe
 Height of mark.....m. ^{above}/_{below} rock/concrete; Mark is.....m. ^{above}/_{below} G.L.
 Height of Top Vanes to Top Mark/Pillar plate.....m. Diameter of Vanes (vertical).....m.
 Height of Cairn.....m. Diameter of Cairn.....m. Name/Plate found/not found/placed.
 Length of Mast.....m. (approximate if not unpiled)
- 4. A..... set in conc/rock has been placed/found, bearing.....° M from Mast/Plug/Pillar
- 5. A..... set in conc/rock has been placed/found, bearing.....° M from Mast/Plug/Pillar
- 6. A..... set in conc/rock has been placed/found, bearing.....° M from Mast/Plug/Pillar
- 7. A..... set in conc/rock has been placed/found, bearing.....° M from Mast/Plug/Pillar
- 8. Action required:.....


STANDPOINT:

Mark	Direction	Horiz. Distance	Height Difference	Mark	Direction	Horiz. Distance	Height Difference
			above standpt.				above standpt.
			below standpt.				below standpt.
			above standpt.				above standpt.
			below standpt.				below standpt.
			above standpt.				above standpt.
			below standpt.				below standpt.
			above standpt.				above standpt.
			below standpt.				below standpt.

Prepared by: *[Signature]*

Checked: *[Signature]*

Noted on U.T.M. Card

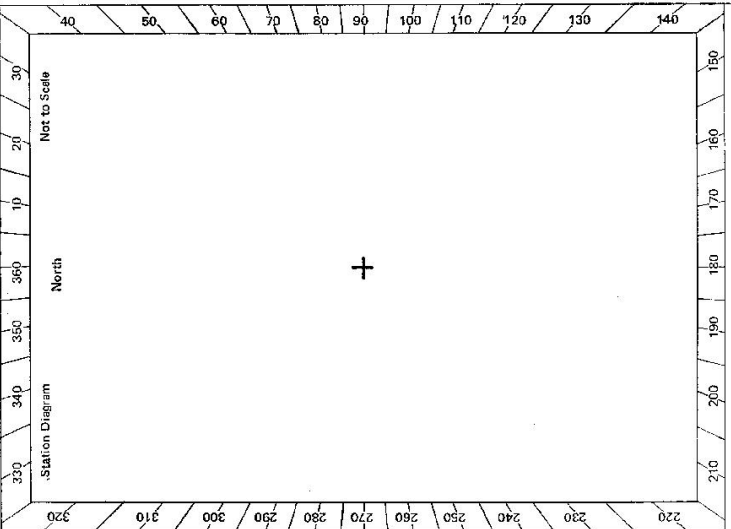

G

St. 2735-2 D. West, Government Printer

Net to Scale

Beacon Diagram

Wooden quadruped collapsed.

This section to be completed by officer constructing pillar.

Original station mark found/not found.

Description of mark:

Original beacon found/not found.

Description of beacon:

Height Top of Vanes to Top Mark.....m.

Height of mark.....m. above G.L.
below rock/cut.

Diameter of Vanesm. Height of Cairn.....m.

Original Beacon has/not been destroyed by me.

STATION **SMA 435** TS **385**
March 1979
 Current Occupant:

Owner's Name: **KOSCIUSKO NATIONALS PARK**
Port Phillip Fire Trail
Tantongera Reservoir
SMA 435 BEDE
Sink 124500

Date: **March 1979** Record of Station:

See **Tantongera Reservoir 2 Rules Book 125,000**
From Tantongera Dam 2 Snowy Mountains Hwy

March 1979 Visited Station on low clear hill. Not recommended for pyrotechnic station.