

CENTRAL MAPPING AUTHORITY
Department of Lands

Trigonometrical Survey of N.S.W.

RECONNAISSANCE and MAINTENANCE REPORT

This Trig. Station has been:-

Note: Cross out word or words which do not apply

1. Completely cleared to permit 360° vision to surrounding trig.
2. Cleared by lances bearing 171° grid from Trig. Mast
3. Trig. Mast & Vanes have been painted white & black respectively.
4. The Trig. was unpiled/not unpiled, dimensions now being:

Description of mark..... Plug..... should be explicit, e.g. Steel plug, Brass plug, Bolt, G.I. Pipe
 Height of mark..... m above rock/concrete m below G.L.
 Height of Top Vanes to Top Mark..... m. Diameter of Vanes (vertical)..... m.
 Height of Cairn..... m. Diameter of Cairn..... m.

Length of Mast..... m. (approximate if not unpiled)

5. A..... set in conc/rock has been placed..... m. bearing.....°M from Trig. Mast
6. A..... set in conc/soil has been placed..... m. bearing.....°M from Trig. Mast
7. A..... set in conc/soil has been placed..... m. bearing.....°M from Trig. Mast
8. A..... set in conc/rock has been placed..... m. bearing.....°M from Trig. Mast

9. Connection..... to..... m. bearing.....°M

10. Connection..... to..... m. bearing.....°M

11. Connection..... to..... m. bearing.....°M

12. Connection..... to..... m. bearing.....°M

13. Diff. Ht. is..... m. above below

14. Diff. Ht. is..... m. above below

15. Diff. Ht. is..... m. above below

16. Diff. Ht. is..... m. above below

Prepared by: B.J. MITCHELL 6. 8. 75 Checked: J.H. GILLIES 6. 11. 75 Noted on U.T.M. Card

STATION REDDALL TS 3871

Co: KING Ph: YASS

Map Sheet: No:

Inspected by: J.H. GILLIES Date: 18. 2. 75

Authority: D.M.R. Field Book:

Beacon Diagram Not to Scale

MAST ROTTED, VANES & CAIRN DESTROYED

Date Record of Station

Checked


STATION REDDALL TS 3871

M	104
0	162
0	305
1	727

Note Brass plug for
Reddall TS found.
Crown unsplit.
Mast rotted.


Owners Name.....
Address.....
Access 18-2-1475

2/9457 121°
2/9456 109°
2/9453 183°
2/9451 281°
Bowling TS. 288°
Wharero TS. 200°
Terry TS. 165°
2/9460 160°

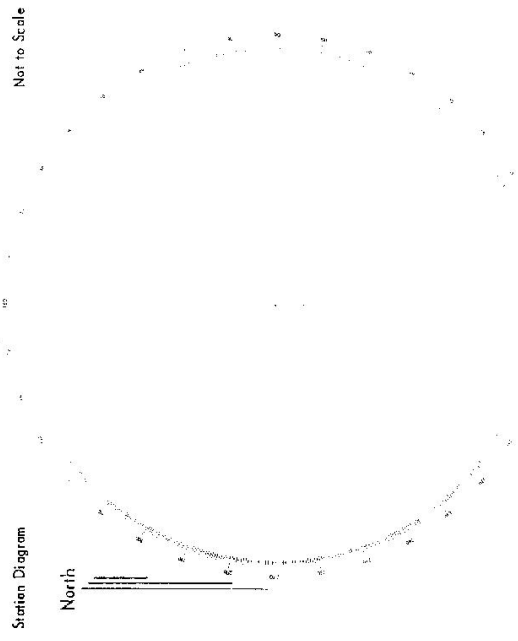

List of Observed Directions:-

Standpoint:		Station	
Station	Direction	Station	Direction

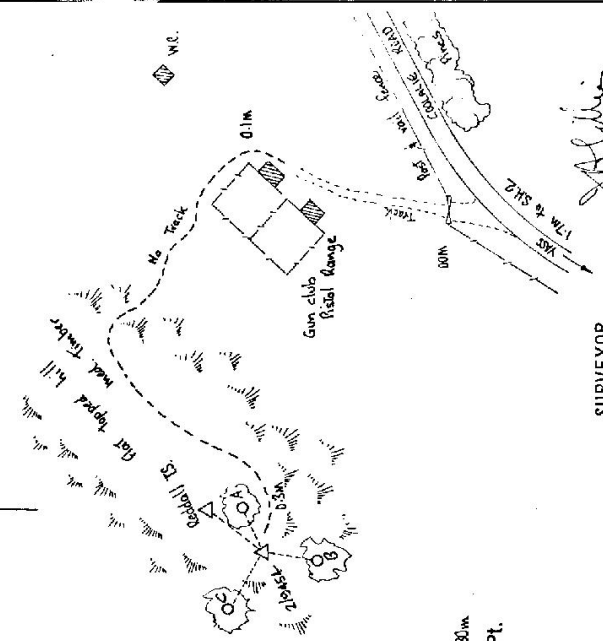

"A": flash on gun 50' - 11m
"B": " " " 247' - 14m
"C": " " " 343' - 20m
Reddall TS. 68° - abt 90m
Description of Photo Control Pt.
No Photo point

SURVEYOR.....
Date.....

Photo Target required : YES/NO
F1443 Within for 15 Ph. YASS