

CENTRAL MAPPING AUTHORITY

GEODETTIC SURVEY OF N.S.W.

GEODETTIC STATION RECONNAISSANCE and MAINTENANCE REPORT

Description:

1. Cleared by lanes bearing 132.72° M, 312.7° M, 325.5° M, 355.5° M, 35° M, 85° M, 130° M from Trig. Mast
 Note: Cross out word or words which do not apply

2. Mast & Vanes have been painted white & black respectively. ✓

3. The station/pillar was ~~reconstructed~~ ^{MANIPULATED} on 25.5 5 192.5 dimensions now being:

Description of mark ~~of Rock~~ ^{of Rock} should be explicit, e.g. S/Steel Pillar Plate, Steel plug, Brass plug, Bolt, G.I. Pipe

Height of mark ~~is~~ ^{is} 1.016 m. ~~above~~ ^{above} ~~rock~~ ^{rock} ~~structure~~; Mark is 1.1 m. ~~above~~ ^{above} G.L.

Height of Top Vanes to Top Mark/Pillar plate 1.47 m. Diameter of Vanes (vertical) 75 m.

Height of Cairn m. Diameter of Cairn m. Name Plate found/~~not found~~/placed.

Length of Mast 5.55 m. (~~approximate~~ ^{not attempted})

4. A. set in conc/rock has been placed/found, bearing° M from Mast/Plug/Pillar

5. A. set in conc/rock has been placed/found, bearing° M from Mast/Plug/Pillar

6. A. set in conc/rock has been placed/found, bearing° M from Mast/Plug/Pillar

7. A. set in conc/rock has been placed/found, bearing° M from Mast/Plug/Pillar

8. Action required:

STANDPOINT:

STANDPOINT:

Mark	Direction	Horiz. Distance	Height Difference	Mark	Direction	Horiz. Distance	Height Difference
			above standpt				above standpt
			below				below
			above standpt				above standpt
			below				below
Prepared by: D. Cairn

Checked: *[Signature]* Noted on U.T.M. Card *[Signature]*

STATION: RED HEAD CONG. PILLAR No: 3872
 MAP SHEETS SCALE 1:250 000 SCALE 1:100 000
 LARK M.A.C. QUAD
 INSPECTED BY: D. J. Cairn DATE: 25.5.1985
 AUTHORITY: C.M.A. FIELD BOOK: C434
 Station Diagram
 Not to Scale
 STATION WAS VISITED FOR PURPOSE OF STATION MAINTENANCE and INSPECTION ONLY.
 WITH PERMISSION about 3-4 HOURS TO CLIMB 300' SIGHT.
 SOME GROWTH WILL REMAIN ABOUT 1 METRE ABOVE GROUND LEVEL.
 +
 Checked: *[Signature]*

STATION RED HEAD Concrete Pillar No. 3872

Owner's Name:
 Address:
 Phone:

Current Occupant:
 Address:
 Phone:


ACCESS

Access Report of 25/5/1985 was found suitable/unsuitable.

KMS FEATURE

- ✓ 0.00 AT SMALL SHOPPING CENTRE END OF RED HEAD POST OFFICE TRAVEL EASTERLY ALONG "LOWLISHAW STREET"
 - ✓ 0.69 TURN RIGHT INTO "ALLARD STREET"
 - ✓ 0.92 TURN LEFT INTO "ALISON STREET"
 - ✓ 1.00 TURN LEFT INTO "ALISON STREET"
 - ✓ 1.89 TURN LEFT.
 - ✓ 1.95 STEEL BARRIcade across access TRACK.
- 5 MINUTE WALK TO STATION SITUATED ON HEATH COVERED SANDY FEATURE.

et 2733-2-D, West, Government Printer

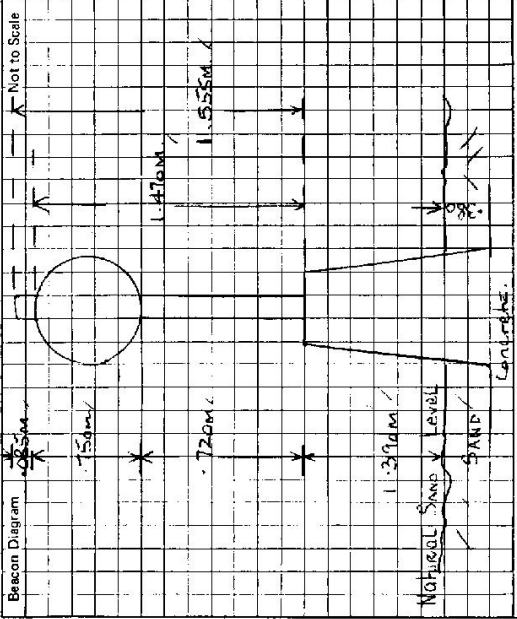

This section to be completed by officer constructing pillar.

Original station mark found/not found.

Description of mark:

Original beacon found/not found.

Description of beacon:

Height Top of Vanes to Top Markm.
 above below
 Height of markm. rock/concm. below G.L.
 Diameter of Vanesm. Height of Calmm.

Original Beacon has/not been destroyed by me.

Date	Record of Station