

Department of Lands

Integration by of N.S.W.

RECONNAISSANCE and MAINTENANCE REPORT 3882 STATION RED HILL (P) TS 3882

Co: Northumberland Ph: Mildred
 Map Sheet: CESNOCK No: 9132
 Inspected by: D.R. GRAHAM Date: 23-3-76
 Authority: I.S.D. Newcastle Field Book: 334/19
 Beacon Diagram

This Trig. Station has been:-

Note: Cross out words or words which do not apply

1. Completely cleared to permit 360° vision to surrounding trigs.
2. Cleared by lanes bearing Clear from 5°M to 340°M from Trig. Mast
3. Trig. Mast & Vanes have been painted white & black respectively. ✓
4. The Trig. was unpiled/~~unpiled~~ dimensions now being:

Description of mark: Concrete Pillar should be explicit, e.g. Steel plug, Brass plug, Bolt, Concrete Pillar

Height of mark: 1.39 m ^{above} rock/concrete 1.39 m ^{above} G.L.
 Height of Top Vanes to ~~Top~~ Top pillar plate 1.465 m Diameter of Vanes (vertical) 0.75 m.
 Height of ~~Plate~~ Pillar 1.39 m. Diameter of ~~Plate~~ 33 x 55 m.
 Length of Mast 1.56 m. (approximate if not unpiled)

5. A SSM set in conc/~~rock~~ has been ~~placed~~ placed 6.658 m. bearing 138 °M from Trig. Mast/pillar
6. A Trig. Plug set in conc/~~soil~~ has been ~~placed~~ placed 2.435 m. bearing 155 °M from Trig. Mast/pillar
7. A set in conc/soil has been placed fd m. bearing °M from Trig. Mast/pillar
8. A set in conc/rock has been placed fd m. bearing °M from Trig. Mast/pillar

9. Connection Trig. Plug to SSM : 4.384 m. bearing 130 °M

10. Connection to : m. bearing °M

11. Connection to : m. bearing °M

12. Connection to : m. bearing °M


13. Diff. Ht. Pillar. Plate is 1.695 m. ^{above} SSM

14. Diff. Ht. Pillar. Plate is 1.592 m. ^{above} Trig. Plug

15. Diff. Ht. Trig. Plug is 0.152 m. ^{above} SSM

16. Diff. Ht. is m. ^{above} SSM

Prepared by: DRG Checked: Allen B. ...

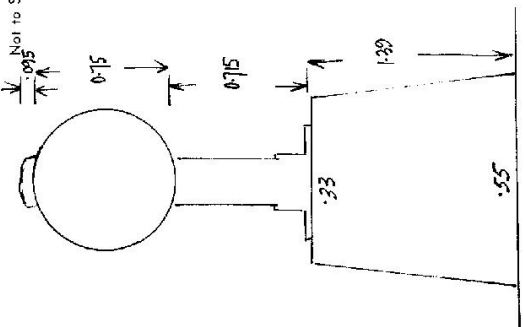

Date	Record of Station

GEODETIC SURVEY OF M.S.V.

CENTRAL MAPPING AUTHORITY

GEODETIC STATION RECONNAISSANCE and MAINTENANCE REPORT

Description:

1. Cleared by lanes bearing... *Eastwards to... from Trig. Mast*
Light Lanes to hours. (small to medium regrowth trees)
Inspected mass of vanes replaced.
2. Mast & Vanes have been painted white & black respectively.
Station/pillar was replaced with...
3. The station/pillar was replaced with...
sr. steel cap & bolts attached to pillar plate.
*Description of mark: 3.79 m. above ~~rock~~ *steel* plate should be explicit, e.g., S/Steel Pillar Plate, Steel plug, Brass plug, Bolt, G.I. Pipe*
- Height of mark... 3.79 m. above ~~rock~~ *steel* *mark* is 1.370 m. *above* ~~G.I.~~ *G.I.*
- Height of Top Vanes to Top ~~mark~~ *mark*/Pillar plate 1.460 m. Diameter of Vanes (vertical) 0.150 m.
- Height of Cairn... m. Diameter of Cairn... m. *Name Plate found/*
*Length of Mast 1.550 m. (approximate if not unplied) *C.M.A. Leadline Station.**
4. A... *S.M.* set in conc/~~rock~~ *set* has been placed/found, bearing 138 M from Mast/~~Plug~~ *Red Hill TS.*
*5. A... *S.I.* pipe set in conc/~~rock~~ *set* has been placed/found, bearing 92 M from Mast/~~Plug~~ *1912.**
6. A... set in conc/rock has been placed/found, bearing... M from Mast/~~Plug~~ *Pillar*
7. A... set in conc/rock has been placed/found, bearing... M from Mast/~~Plug~~ *Pillar*
8. Action required:.....

STANDPOINT:

Mark	Direction	Horiz. Distance	Height Difference	Mark	Direction	Horiz. Distance	Height Difference
			above standpt.				above standpt.
			below				below
			above standpt.				above standpt.
			below				below
Prepared by:

Checked: *See 1st page* *Noted on U.T.M. Card*

ST 2738-1

STATION: **RED HILL (Pillar)** No.: **3882**

MAP SHEET SCALE: 1:250 000

INSPECTED BY: **D.J. Kain** DATE: **6 April 1979**

AUTHORITY: **C.M.A.** FIELD BOOK: **1613**

Station Diagram

Checked

STATION RED HILL (Pillae) TS 3882	Owner's Name: Address: Phone: Current Occupant: Address: Phone: Access Report of/...../19..... was found suitable/unsuitable. ACCESS
Beacon Diagram Not to Scale 	This section to be completed by officer constructing pillar. Original station mark found/not found. Description of mark: Original beacon found/not found. Description of beacon: Height Top of Vanes to Top Markm. Height of markm. above G.L. / below G.L. Diameter of Vanesm. Height of Cairnm. Original Beacon has/had not been destroyed by me.
Date	Record of Station


STATION **RED HILL (P)** TS 3882

Owners Name: Current Occupant:

Address: Address:

Access **23-3-1976**
 From Lochmar - Travel New England Highway towards Singleton approx 2 Km.
 0-0. New England Highway and Allendale RA Iden.
 1-6. Railway underpass.
 3-8 Take gravel road on right.
 5-4 Left through wooden gate and follow track to old cottage.
 5-7 Left along fence to top of ridge (fence on R.H.S.)
 6-5 Drop wire gate.
 Follow ridge to track cut in side of hill
 Follow track to Trig.
 7-0 Trig

Access by station section in dry conditions.

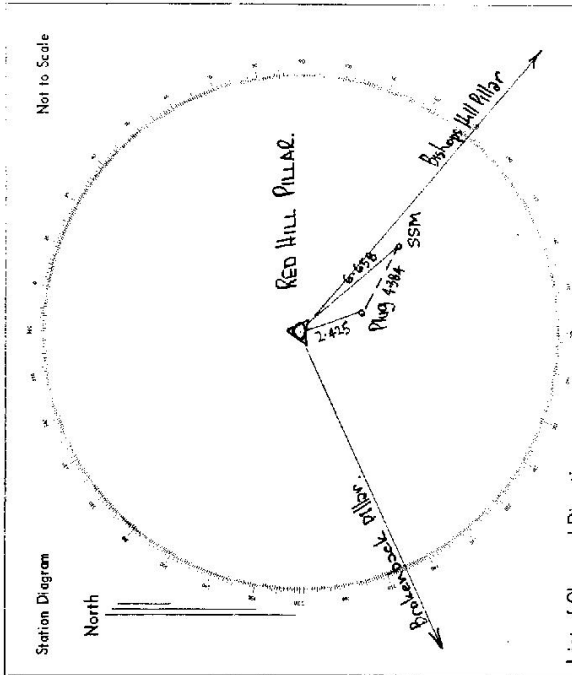

List of Observed Directions:-

Standpoint: Pillar		Standpoint: Plug	
Station	Direction	Station	Direction
Bishops Hill Pillar	0° 00' 00"	Bishops Hill Pillar	0° 00' 00"
SSM	8° 29' 51.5"	Brokenback Pillar	10° 22' 36.5"
Plug	24° 36' 27"	Pillar	200° 57' 05"
Brokenback Pillar	110° 21' 26.5"	SSM	200° 41' 51.0"
Station	Direction	Station	Direction

