

CENTRAL MAPPING AUTHORITY

GEODETIC SURVEY OF M.S.L.W.


GEODETIC STATION RECONNAISSANCE and MAINTENANCE REPORT

STATION: SMA 0579 No.: 389

MAPSHEET SCALE 1:250 000 BEGA

INSPECTED BY: G. KEEP DATE: 27/12/80

AUTHORITY: FIELD BOOK:

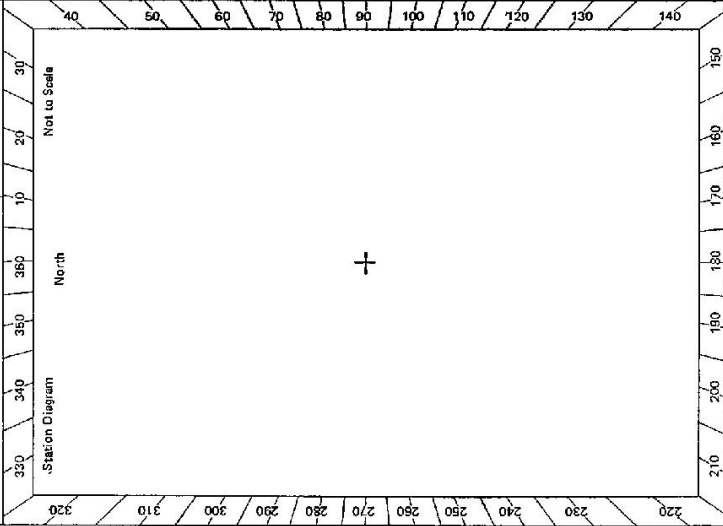

- Description:
1. Cleared by lanes bearing..... Note: Cross out word or words which do not apply
2. ~~Mast & Vanes have been painted white & black respectively~~..... from Trig. Mast
3. The station/pillar was unpiled/not unpiled/constructed on..... 19....., dimensions now being:
- Description of mark..... should be explicit, e.g. S/Steel Pillar Plate, Steel plug, Brass plug, Bolt, G.I. Pipe
- Height of mark.....m, ^{above} below rock/concrete; Mark is.....m, ^{above} below G.L.
- Height of Top Vanes to Top Mark/Pillar plate.....m. Diameter of Vanes (vertical).....m.
- Height of Cairn.....m. Diameter of Cairn.....m. Name Plate found/not found/placed.
- Length of Mast.....m. (approximate if not unpiled)
4. A.....set in conc/rock has been placed/found, bearing.....°M from Mast/Plug/Pillar
5. A.....set in conc/rock has been placed/found, bearing.....°M from Mast/Plug/Pillar
6. A.....set in conc/rock has been placed/found, bearing.....°M from Mast/Plug/Pillar
7. A.....set in conc/rock has been placed/found, bearing.....°M from Mast/Plug/Pillar
8. Action required: *Needs painting black and white*

STANDPOINT:

Mark	Direction	Horiz. Distance	Height Difference	Mark	Direction	Horiz. Distance	Height Difference
			above standpt.				above standpt.
			below standpt.				below standpt.
			above standpt.				above standpt.
			below standpt.				below standpt.
STANDPOINT:

Mark	Direction	Horiz. Distance	Height Difference	Mark	Direction	Horiz. Distance	Height Difference
			above standpt.				above standpt.
			below standpt.				below standpt.
			above standpt.				above standpt.
			below standpt.				below standpt.
Prepared by: G. Keep 12/6/80

Checked:

Checked

Noted on U.T.M. Card

CENTRAL MAPPING AUTHORITY

GEODETTIC SURVEY OF N.S.W.

GEODETTIC STATION RECONNAISSANCE and MAINTENANCE REPORT

STATION: SMA 579 No: 389

MAP SHEET

SCALE 1:250 000


INSPECTED BY: I. Robins

DATE: 13.7.82

AUTHORITY: CMA

FIELD BOOK:


- Description:
 Cleared by vanes bearing..... *Cleared 300° Sensitive to interference from Trig. Mast*
 Mast & Vanes have been painted ~~white & black respectively~~ and need repainting
 3. The station/pillar was unpiled/not unpiled/constructed on..... 19....., dimensions now being:
 Description of mark..... should be explicit, e.g., S/Steel Pillar Plate, Steel plug, Brass plug, Bolt, G.I. Pipe
 Height of mark.....m. ^{above} rock/concrete; Mark is.....m. ^{above} G.L.
 Height of Top Vanes to Top Mark/Pillar plate.....m. Diameter of Vanes (vertical).....m.
 Height of Cairn.....m. Diameter of Cairn.....m. Name Plate found/not found/placed.
 Length of Mast.....m. (approximate if not unpiled)
 4. A..... set in conc/rock has been placed/found, bearing.....° M from Mast/Plug/Pillar
 5. A..... set in conc/rock has been placed/found, bearing.....° M from Mast/Plug/Pillar
 6. A..... set in conc/rock has been placed/found, bearing.....° M from Mast/Plug/Pillar
 7. A..... set in conc/rock has been placed/found, bearing.....° M from Mast/Plug/Pillar
 8. Action required: *repainting* *replacement of vanes*

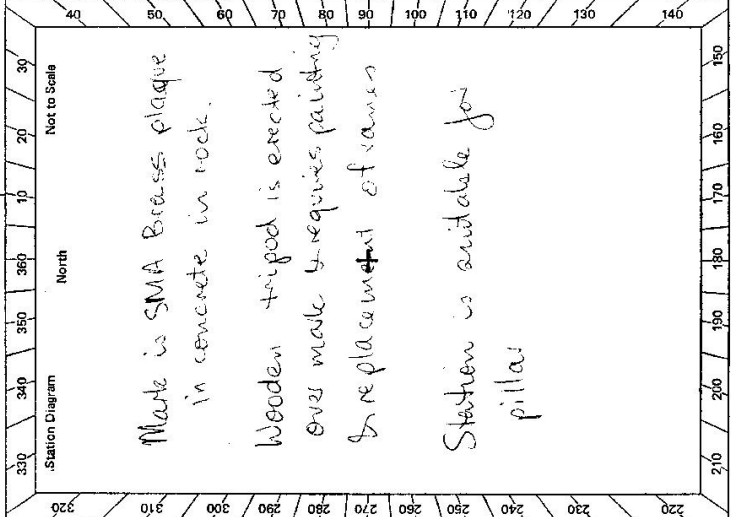

STANDPOINT:		STANDPOINT:		STANDPOINT:		STANDPOINT:	
Mark	Direction	Horiz. Distance	Height Difference	Mark	Direction	Horiz. Distance	Height Difference
			above standpt.				above standpt.
			below				below
			above standpt.				above standpt.
			below				below
Prepared by: I. Robins Checked: Noted on U.T.M. Card

GS 24

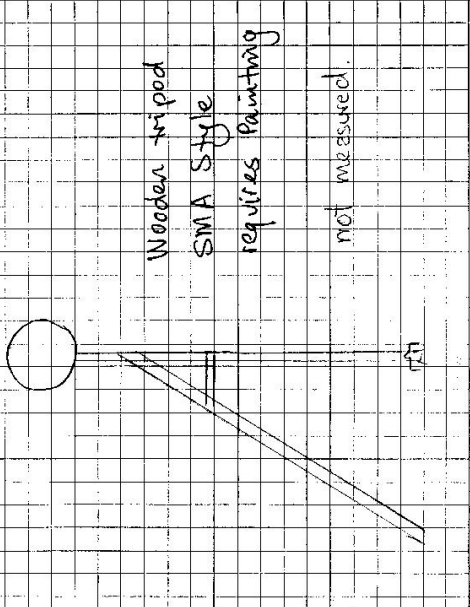Sr: 2733--2 D. West, Government Printer Beacon Diagram	Not to Scale  <p>Wooden tripod SMA Style requires painting not measured.</p>	STATION SMA 579 TS 389 Owner's Name: Address: Phone: Current Occupant: Address: Phone: ACCESS Access Report of <u>12/1/1982</u> was found suitable/unsuitable. Access is from South East via properties north of intake dam on Mewambah River see Bewickie 1:100000 Map (coords 463, 627). Route has been seen from trig but not investigated by me. Gtks locked (by Electricity Commission) may be found SW, 1/4 west of station. See Dindabyne Elcom. Bk keys.
This section to be completed by officer constructing pillar. Original station mark found/not found. Description of mark: Original beacon found/not found. Description of beacon: Height Top of Vanes to Top Mark:m. Height of mark:m. above G.L. /m. below Diameter of Vanes:m. Height of Cairn:m. Original Beacon has/has not been destroyed by me.		Date Record of Station

CENTRAL MAPPING AUTHORITY

GEODETTIC SURVEY OF N.S.W.

GEODETTIC STATION RECONNAISSANCE and MAINTENANCE REPORT

STATION: SMA 579 No.: 389


MAP SHEETS SCALE 1:250 000 BEGA SCALE 1:100 000 BERRIGALLA

INSPECTED BY: K. HADDON DATE: 26-8-87

AUTHORITY: C.M.A. FIELD BOOK:

Description: Note: Cross out word or words which do not apply

1. Cleared by lanes bearing 360° above 15° elevation 10° from Trig. Mast
2. Mast & Vanes have been painted white & black respectively.
3. The station/~~pillar~~ was ~~used~~/not unpiled/~~concrete~~ on $26-8-87$, dimensions now being: Description of mark ~~SMA~~ 10° above 15° elevation 10° from Trig. Mast should be explicit, e.g., S/Steel Pillar Plate, Steel plug, Brass plug, Bolt, G.I. Pipe
Height of mark 15° above rock/concrete; Mark is 10° above G.L.
Height of Top Vanes to Top Mark/Pillar platem. Diameter of Vanes (vertical).....m.
Height of Cairn.....m. Diameter of Cairn.....m. Name Plate found/not found/placed.
Length of Mastm. (approximate if not unpiled)
4. A.....set in conc/rock has been placed/found, bearing..... $^\circ$ M from Mast/Plug/Pillar
5. A.....set in conc/rock has been placed/found, bearing..... $^\circ$ M from Mast/Plug/Pillar
6. A.....set in conc/rock has been placed/found, bearing..... $^\circ$ M from Mast/Plug/Pillar
7. A.....set in conc/rock has been placed/found, bearing..... $^\circ$ M from Mast/Plug/Pillar
8. Action required:.....

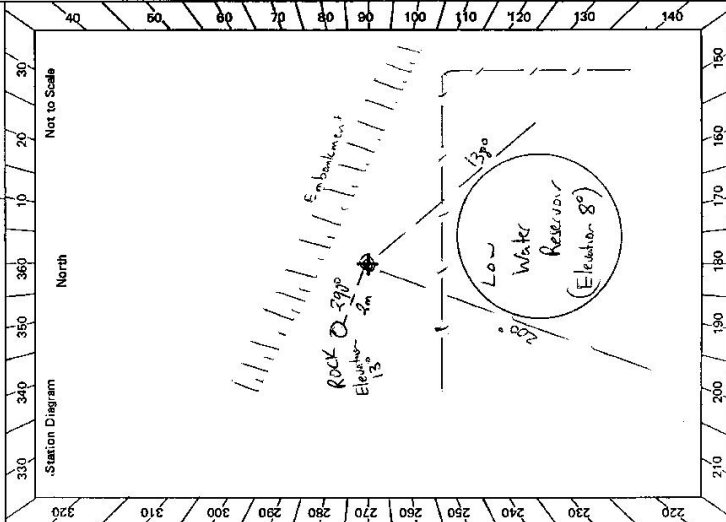

STANDPOINT:			
Mark	Direction	Horiz. Distance	Height Difference
			above standpt.
			below
			above standpt.
			below
Prepared by: *[Signature]* Checked: *[Signature]* Noted on U.T.M. Card

2733-2 D. West, Government Printer

STATION SMA 579 TS 389																					
Owner's Name: Address: Phone:	Current Occupant: Address: Phone:																				
ACCESS Access Report of 26.8.1987 ^{26.8.1987} was found suitable/unsuitable.																					
<table border="1" style="width: 100%; border-collapse: collapse;"> <tr><td style="width: 10%; text-align: center;">00</td><td>Memorial Hill in Shopping Centre Tindobvne Head towards Thielbo</td></tr> <tr><td style="text-align: center;">05</td><td>Straight ahead through roundabout</td></tr> <tr><td style="text-align: center;">12</td><td>Turn left towards Ingebyra</td></tr> <tr><td style="text-align: center;">55</td><td>Turn left</td></tr> <tr><td style="text-align: center;">58</td><td>Straight ahead through roundabout</td></tr> <tr><td style="text-align: center;">72</td><td>Turn left onto Ridge Avenue and cross grid.</td></tr> <tr><td style="text-align: center;">77</td><td>Pass Snowy Ave on right</td></tr> <tr><td style="text-align: center;">79</td><td>Pass Lakewood Drive on left.</td></tr> <tr><td style="text-align: center;">795</td><td>Turn left onto track to water tanks.</td></tr> <tr><td style="text-align: center;">81</td><td>Trig (at northern end of tanks.)</td></tr> </table>	00	Memorial Hill in Shopping Centre Tindobvne Head towards Thielbo	05	Straight ahead through roundabout	12	Turn left towards Ingebyra	55	Turn left	58	Straight ahead through roundabout	72	Turn left onto Ridge Avenue and cross grid.	77	Pass Snowy Ave on right	79	Pass Lakewood Drive on left.	795	Turn left onto track to water tanks.	81	Trig (at northern end of tanks.)	
00	Memorial Hill in Shopping Centre Tindobvne Head towards Thielbo																				
05	Straight ahead through roundabout																				
12	Turn left towards Ingebyra																				
55	Turn left																				
58	Straight ahead through roundabout																				
72	Turn left onto Ridge Avenue and cross grid.																				
77	Pass Snowy Ave on right																				
79	Pass Lakewood Drive on left.																				
795	Turn left onto track to water tanks.																				
81	Trig (at northern end of tanks.)																				
Date	Record of Station																				

Beacon Diagram Not to Scale <div style="border: 1px solid black; padding: 5px; font-family: monospace; font-size: 0.8em;"> Wooden Tripod held in place by rocks Allow 20-30 minutes to remove. </div>	
This section to be completed by officer constructing pillar. Original station mark found/not found.	
Description of mark: Original beacon found/not found.	
Description of beacon Height Top of Vanes to Top Mark m.	
Height of mark m. above below rock/conc m. above below G.L.	
Diameter of Vanes m. Height of Cairn m.	
Original Beacon has/has not been destroyed by me.	