


GEODETTIC SURVEY OF N.S.W.

CENTRAL MAPPING AUTHORITY

GEODETTIC STATION RECONNAISSANCE and MAINTENANCE REPORT

STATION: RESERVOIR GS No: TS 3893  
 MAP SHEET SCALE 1:250 000 Grafton  
 INSPECTED BY: J. Fanning DATE: 21/9/78  
 AUTHORITY: CMA (CMA 67/2/2) FIELD BOOK: —

- Description: *(Note: Cross out word or words which do not apply)*
- Cleared by ~~lines-bearing~~ *orig. position obscured by trees and reservoirs* from Trig, Mast
  - Mast & Vanes have been painted white & black respectively. **found destroyed**
  - The station/~~pillar~~ **was unspliced/rot unspliced/constructed on** *to* dimensions *now being:*
- Description of mark: *should be explicit, e.g., S/Steel Pillar Plate, Steel plug, Brass plug, Bolt, G.I. Pipe*
- Height of mark: *m. above below rock/concrete;* Mark is *m. above below G.L.*
- Height of Top Vanes to Top Mark/Pillar plate *m.* Diameter of Vanes (vertical) *m.*
- Height of Cairn: *m.* Diameter of Cairn: *m.* Name Plate found/not found/placed.
- Length of Mast: *m.* *(approximate if not unspliced)*
- A. *set in conc/rock has been placed/found, bearing* *°M* from Mast/Plug/Pillar
  - A. *set in conc/rock has been placed/found, bearing* *°M* from Mast/Plug/Pillar
  - A. *set in conc/rock has been placed/found, bearing* *°M* from Mast/Plug/Pillar
  - A. *set in conc/rock has been placed/found, bearing* *°M* from Mast/Plug/Pillar
8. Action required: *Adoption of I.S.D. Pillar.*

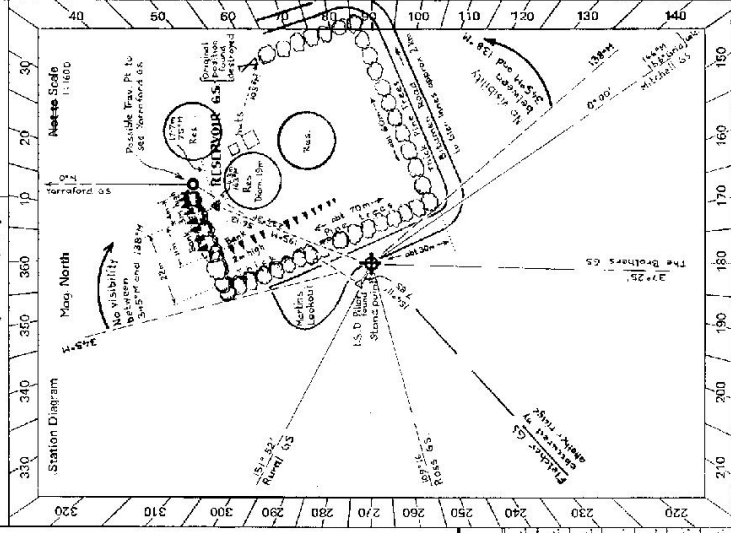


STANDPOINT:			
Mark	Direction	Horiz. Distance	Height Difference
			above standpt.
			below standpt.
			above standpt.
			below standpt.
Prepared by: *J. Fanning* Checked: *J.F.*

St 2735-2 D. West, Government Printer

STATION RE SERVOIR GS TS 3893

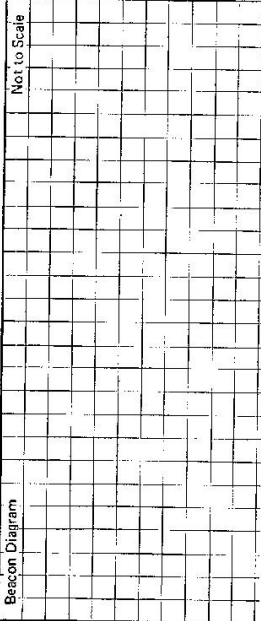

Owner's Name: .....  
 Address: .....  
 Phone: .....  
 Current Occupant: .....  
 Address: .....  
 Phone: .....

ACCESS  
 Access Report of 21/11/1988 was found suitable/unsuitable.

Near Martins Lookout, approx 2km from Glen Innes P.O. (See diagram overleaf)

						Mean	Htz. Dist
A	Mitchell GS	0°	00'	00"	00"	00"	00"
B	The Brothers GS	37	24	40	42	42.5	41.5 ✓
C	Ross GS	109	15	46	41.5	47	44.8 ✓
D	Rural GS	151	51	35.5	34	35.5	35.2 ✓
	150 Pillar	154	10	48			48 7.848 ✓

Standpoint to Mitchell GS Grid  
 150° 07' 00" 0° 00' 00" Htz. dist.  
 Standpoint to Reservoir GS 30 37 52 234 30 52 56.13m ✓

Original station mark found/not found.  
 Description of mark: .....  
 Original beacon found/not found.  
 Description of beacon: .....  
 Height Top of Vane to Top Mark: .....m.  
 Height of mark: .....m. above rock/stone .....m. below G.L.  
 Diameter of Vane: .....m. Height of Cairn: .....m.  
 Original Beacon has/has not been destroyed by me.

Date	Record of Station