

GEODETTIC SURVEY OF N.S.W.

CENTRAL MAPPING AUTHORITY

GEODETTIC STATION RECONNAISSANCE and MAINTENANCE REPORT

Description: *Note: Cross out word or words which do not apply*

1. Cleared by lanes bearing..... *Note: Cross out word or words which do not apply*..... from Trig, Mast
2. Mast & Vanes have been painted white & black respectively.
3. The station/pillar was unpiled/not unpiled/constructed on.....19....., dimensions now being: Description of mark.....should be explicit, e.g., S/Steel Pillar Plate, Steel plug, Brass plug, Bolt, G.I. Pipe
- Height of mark.....m. ^{above}/_{below} rock/concrete; Mark is.....m. ^{above}/_{below} G.L.
- Height of Top Vanes to Top Mark/Pillar plate.....m. Diameter of Vanes (vertical).....m.
- Height of Cairn.....m. Diameter of Cairn.....m. Name Plate found/not found/placed.
- Length of Mast.....m. (approximate if not unpiled)
4. A.....set in conc/rock has been placed/found, bearing.....°M from Mast/Plug/Pillar
5. A.....set in conc/rock has been placed/found, bearing.....°M from Mast/Plug/Pillar
6. A.....set in conc/rock has been placed/found, bearing.....°M from Mast/Plug/Pillar
7. A.....set in conc/rock has been placed/found, bearing.....°M from Mast/Plug/Pillar
8. Action required:.....

STANDPOINT:

Mark	Direction	Horiz. Distance	Height Difference	Mark	Direction	Horiz. Distance	Height Difference
			above standpt.				above standpt.
			below standpt.				below standpt.
			above standpt.				above standpt.
			below standpt.				below standpt.
			above standpt.				above standpt.
			below standpt.				below standpt.
			above standpt.				above standpt.
			below standpt.				below standpt.

Prepared by: K. Hason April 1978

Checked: *Noted on U.I.M. Card*


52733-1

STATION: RIDLEY TS No.: 3905

MAP SHEET SCALE 1:250 000 FORBES


INSPECTED BY: K. HASON DATE: 1978

AUTHORITY: C.M.A. FIELD BOOK:

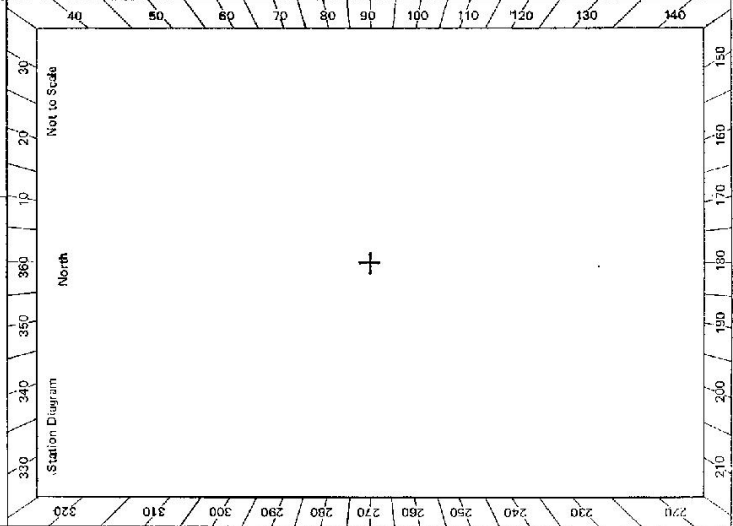

Checked

STATION RIDLEY TS 3905	Owner's Name: Address: Phone: Current Occupant: Address: Phone: Access Report of March 1978 ACCESS of...../19..... was found suitable/unavailable. From Condobolin take Forbes Road on south side of Leichia River. 00 Condobolin 27 Turn right and follow this road 48 Cross roads Turn left towards Forbes 54.3 Turn left after crossing irrigation channel 55.7 Turn Right 55.9 Take left track 56.7 Turn left around shed and silos (Homeshead on right) 57.0 Take track to right through gullys 57.6 track turns left 57.9 Through gate and turn right 58.1 Turn left off track. Proceed towards hill and find bulldozed track to top Bulldozed track goes to within 40m of trig station.
------------------------	--

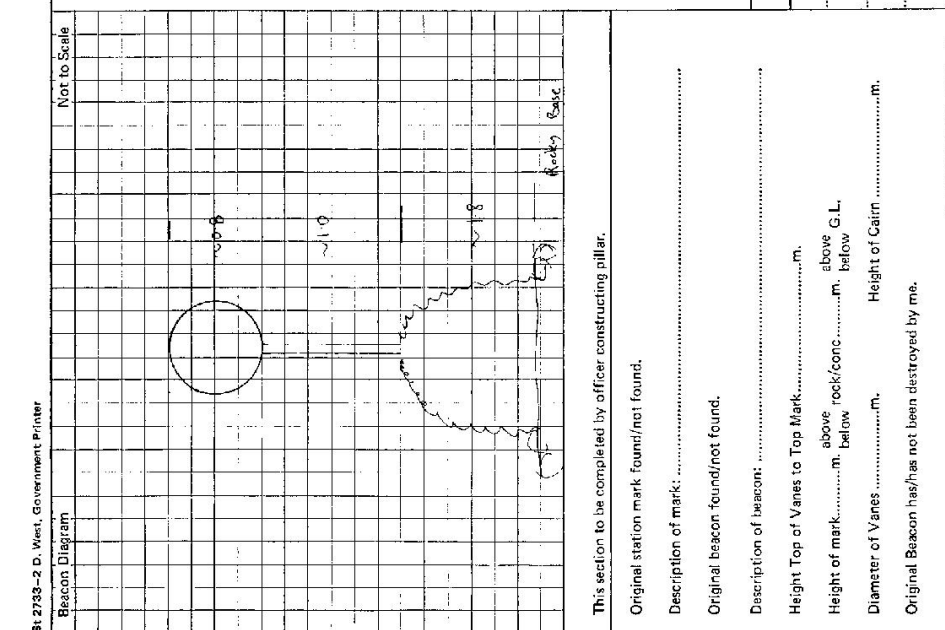

Date	Record of Station
March 1978	Cave up to disk standing. Mast after