

CENTRAL MAPPING AUTHORITY

GEODETIC SURVEY OF N.S.W.

GEODETIC STATION RECONNAISSANCE and MAINTENANCE REPORT


STATION: RIX No.: 3913

Description: *Note: Cross out word or words which do not apply*

MAP SHEET SCALE 1:250 000 BEGR

INSPECTED BY: G. C. HANNA DATE: 7-5-80

AUTHORITY: C. M. F. FIELD BOOK:

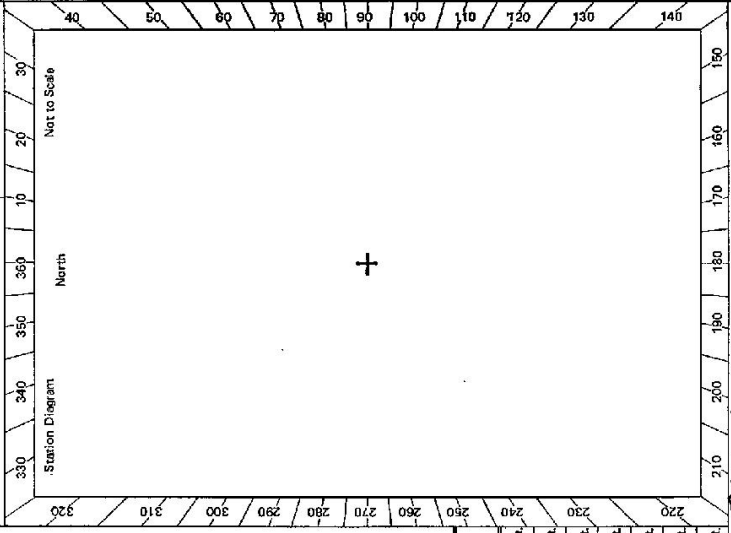

1. Cleared by lanes bearing..... from Fig. Mast
2. Mast & Vanes have been painted white & black respectively.
3. The station/pillar was unpiled/not unpiled/constructed on..... 19....., dimensions now being:
Description of mark..... should be explicit, e.g., S/Steel Pillar Plate, Steel plug, Brass plug, Bolt, G.I. Pipe
Height of mark..... m. ^{above}/_{below} rock/concrete; Mark is..... m. ^{above}/_{below} G.L.
Height of Top Vanes to Top Mark/Pillar plate..... m. Diameter of Vanes (vertical)..... m.
Height of Cairn..... m. Diameter of Cairn..... m. Name Plate found/not found/placed.
Length of Mast..... m. (approximate if not unpiled)
4. A..... set in conc/rock has been placed/found, bearing..... ° M from Mast/Plug/Pillar
5. A..... set in conc/rock has been placed/found, bearing..... ° M from Mast/Plug/Pillar
6. A..... set in conc/rock has been placed/found, bearing..... ° M from Mast/Plug/Pillar
7. A..... set in conc/rock has been placed/found, bearing..... ° M from Mast/Plug/Pillar
8. Action required.....

STANDPOINT:				
Mark	Direction	Horiz. Distance	Height Difference	Mark
			above standpt	
			below standpt	
			above standpt	
			below standpt	
Prepared by: G. Hanna 8-5-80 Checked: G. Hanna 27/5/80 Noted on U.T.M. Card

2733-2 D. West, Government Printer

STATION RIX TS 3913

<p>Beacon Diagram</p> <div style="border: 1px solid black; width: 100%; height: 150px; text-align: center; vertical-align: middle;"> Not to Scale </div>	<p>Owner's Name:</p> <p>Address:</p> <p>Phone:</p> <p>Current Occupant:</p> <p>Address:</p> <p>Phone:</p> <p>ACCESS Report of 21/5/1988 was found suitable/unsuitable.</p> <p>See also Tombong 8624 - S.</p> <p>ACCESS</p> <p>0-0 Cooma P.O. Post Cooma Hotel.</p> <p>0-22 R.H. turn, Cross Sharpe St., go towards Bombala.</p> <p>1-32 R.H. turn towards Bobandara.</p> <p>33-0 L.H. turn on sealed road towards Bungarby.</p> <p>33-4 Take sealed road to right towards Bungarby.</p> <p>38-55 Turn left towards Bungarby.</p> <p>51-3 Turn right towards Bungarby.</p> <p>60-05 Bungarby church.</p> <p>62-6 Take right fork towards Brasssey Creek.</p> <p>66-65 Grid, Merambego sign.</p> <p>69-95 Take track to left past old house and garage.</p> <p>70-2 Gate.</p> <p>70-52 Gate.</p> <p>71-7 Gate.</p> <p>71-7 Yards on left.</p> <p>71-92 L.H. turn through gate and follow fence on right.</p> <p>72-0 Gate. Follow track to trig.</p> <p>73-8 Trig.</p>
<p>This section to be completed by officer constructing pillar.</p> <p>Original station mark found/not found.</p> <p>Description of mark:</p> <p>Original beacon found/not found.</p> <p>Description of beacon:</p> <p>Height Top of Vanes to Top Mark.....m.</p> <p>Height of mark.....m. above G.L. below</p> <p>Diameter of Vanesm. Height of Cairnm.</p> <p>Original Beacon has/has not been destroyed by me.</p>	<p>Date</p> <p>Record of Station</p>