

GEODETTIC SURVEY OF N.S.W.

CENTRAL MAPPING AUTHORITY

GEODETTIC STATION RECONNAISSANCE and MAINTENANCE REPORT

Description: *1. Cleared by lanes bearing*

Note: Cross out word or words which do not apply

2. Mast & Vanes have been painted white & black respectively.

3. The station/pillar was unpiled/not unpiled/constructed on.....19....., dimensions now being:

Description of mark.....should be explicit, e.g., S/Steel Pillar Plate, Steel plug, Brass plug, Bolt, G.I. Pipe

Height of mark.....m. ^{above} _{below} rock/concrete; Mark is.....m. ^{above} _{below} G.L.

Height of Top Vanes to Top Mark/Pillar plate.....m. Diameter of Vanes (vertical).....0.62.....m.

Height of Cairn.....1.00.....m. Diameter of Cairn.....1.20 top 1.25 base m. Name Plate ~~found~~/not found/placed.

Length of Mast.....3.17.....m. (approximate if not unpiled)

4. A.....set in conc/rock has been placed/found, bearing.....° M from Mast/Plug/Pillar

5. A.....set in conc/rock has been placed/found, bearing.....° M from Mast/Plug/Pillar

6. A.....set in conc/rock has been placed/found, bearing.....° M from Mast/Plug/Pillar

7. A.....set in conc/rock has been placed/found, bearing.....° M from Mast/Plug/Pillar

8. Action required:.....

STANDPOINT:

STANDPOINT:

Mark	Direction	Horiz. Distance	Height Difference	Mark	Direction	Horiz. Distance	Height Difference
			above standpt.				above standpt.
			below standpt.				below standpt.
			above standpt.				above standpt.
			below standpt.				below standpt.
Prepared by: *[Signature]*

Checked: *[Signature]*

Noted on U.T.M. Card

ST 2733-1

STATION: **ROCKFIELD**

No.: **TS 3924**

MAP SHEET SCALE 1:250 000


GOULBURN

INSPECTED BY: **M. L. Macerian**

DATE: **26/10/18**

AUTHORITY: **C. M. A.**

FIELD BOOK: **1710**

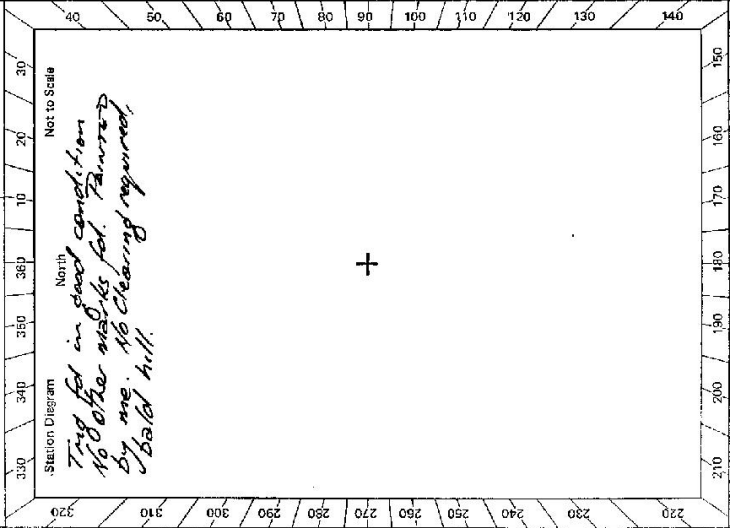

Checked

ST 2733-2 D. West, Government Printer STATION Rockfield G.S. TS 3924	Owner's Name: Address: Phone: ACCESS	Current Occupant: Address: Phone:	
Access Report of 28.10/1978, was found suitable/unsuitable. Direction. 0.00 BANISTER RD. Head towards Gairthorn. 11.25 Turn right then right again towards church. 11.35 Go through white gate next to church. 11.60 Turn left at fence corner follow faint track to top 11.95 ROCKFIELD G.S.		Record of Station Date	
Beacon Diagram Not to Scale	<p style="text-align: center;">0.10 0.62 1.35 1.00 1.20 1.80</p>		
This section to be completed by officer constructing pillar. Original station mark found/not found. Description of mark: Original beacon found/not found. Description of beacon: Height Top of Vanes to Top Markm. Height of markm. above G.L. below rock/concm. below Diameter of Vanesm. Height of Cairnm. Original Beacon has/has not been destroyed by me.			

CENTRAL MAPPING AUTHORITY

GEODETIC SURVEY OF N.S.M.

GEODETIC STATION RECONNAISSANCE and MAINTENANCE REPORT

- Description: *Note: Cross out word or words which do not apply*
1. Cleared ~~by~~ ~~the~~ ~~bearing~~ *10* *REMARKS* *340* *Visible* from Trig. Mast
 2. Mast & Vanes have been painted white & black respectively. *X* *REMARKS* *OLD MAST & VANES FOUND IN GROUND*
 3. The station/~~marker~~ was ~~unplaced~~/not unplaced/~~constructed~~ on *12/ MAY 1924* 1924 dimensions now being: *Rock Cairn* should be explicit, e.g., S/Steel Pillar Plate, Steel plug, Brass plug, Bolt, G.I. Pipe
- Description of mark m. above rock/concrete; Mark is m. above G.L.
- Height of Top Vanes to Top Mark/Pillar plate m. Diameter of Vanes (vertical) *62* m.
- Height of Cairn *900* m. Diameter of Cairn *1.3* m. Name Plate ~~found~~/not found/~~placed~~.
- Length of Mast *REMARKS ONLY* m. (approximate if not unplaced)
4. A. set in conc/rock has been placed/found, bearing ° M from Mast/Plug/Pillar
 5. A. set in conc/rock has been placed/found, bearing ° M from Mast/Plug/Pillar
 6. A. set in conc/rock has been placed/found, bearing ° M from Mast/Plug/Pillar
 7. A. set in conc/rock has been placed/found, bearing ° M from Mast/Plug/Pillar
8. Action required:

STANDPOINT:

Mark	Direction	Horiz. Distance	Height Difference	Mark	Direction	Horiz. Distance	Height Difference
			above standpt				above standpt
			below				below
			above standpt				above standpt
			below				below
STANDPOINT:

Mark	Direction	Horiz. Distance	Height Difference	Mark	Direction	Horiz. Distance	Height Difference
			above standpt				above standpt
			below				below
			above standpt				above standpt
			below				below
Prepared by: *D. J. KAHN*

Checked: _____

Noted on U.T.M. Card

Checked: *DK*


TS 3924

STATION: *Rockfield* *Geodetic Station* No. *34*


MAP SHEETS SCALE 1:250 000 *Geodetic Station*

INSPECTED BY: *D. J. KAHN* DATE: *12 MAY 1924*

AUTHORITY: *C. M. A.* FIELD BOOK: *1924*

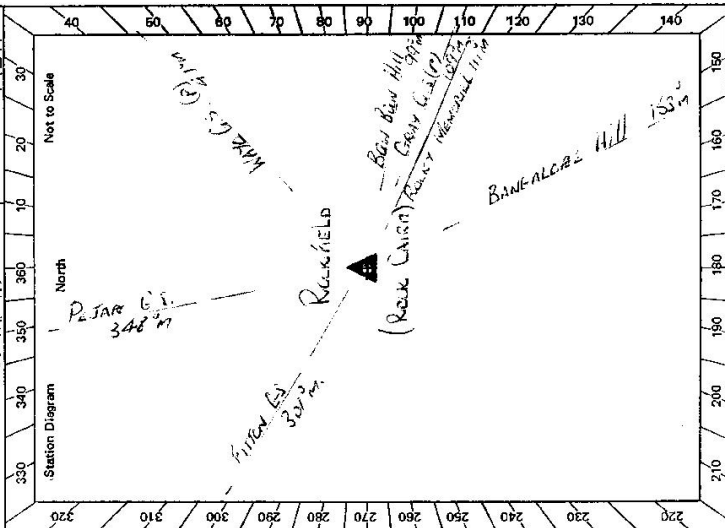

STATION Rockfield Reservoir Station TS 3924

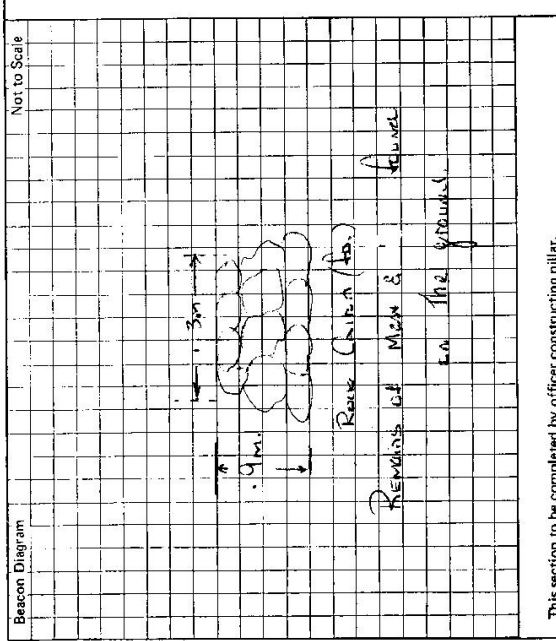

Owner's Name: Mrs. T. C. Craigh
 Address: 16 Railway Place
 Phone: (0622) 821105
 Current Occupant:
 Address:
 Phone:
 ACCESS 12-5-1984

Access Report of 28/10/1982 was found suitable/unsuitable.
 Feature:
0.00 Coulburn P.O. Travel South via Home Highway.
0.39 Highway Turns Right.
0.84 Leave Home Highway and Travel Straight Ahead
5.03 Along Clinton Street.
17.21 Cross Road Bridge over Murrumbidgee River.
18.39 Pass Thompsons Lane on Your R.H.S.
20.08 End of Sealed Road.
20.24 At Top of Hill Make Gravel Bank on Your L.H.S.
20.46 Through Iron Gate Stone Church on Your R.H.S.
20.81 Through Wire Gate at Fence Intersection on Your L.H.S.
 Follow track
 Make own way across Open Redlocks toward centre of hill.
 Rockfield Reservoir Station

Date	Record of Station

This section to be completed by officer constructing pillar.

Original station mark found/not found.

Description of mark:

Original beacon found/not found.

Description of beacon:

Height Top of Vanes to Top Mark:m.

Height of mark:m. above G.L. below

Diameter of Vanesm. Height of Cairnm.

Original Beacon has/not been destroyed by me.