

CENTRAL MAPPING AUTHORITY

GEODETIC SURVEY OF NSW

GEODETIC STATION RECONNAISSANCE and MAINTENANCE REPORT

Description:

Note: Cross out word or words which do not apply

1. Cleared by lanes bearing..... 100° 230° from Trig. Mast
2. Mast & Vanes have been painted white & black respectively.
3. The station/pillar was unpiled/not unpiled/constructed on.....19..... dimensions now being:
Description of mark.....should be explicit, e.g., S/Steel Pillar Plate, Steel plug, Brass plug, Bolt, G.I. Pipe
Height of mark.....m.....^{above} rock/concrete; Mark is.....m.....^{above} G.L.
Height of Top Vanes to Top Mark/Pillar plate.....m..... Diameter of Vanes (vertical).....m.....
Height of Cairn.....m..... Diameter of Cairn.....m..... Name Plate found/not found/placed.
Length of Mast.....m..... (approximate if not unpiled)
4. A.....set in conc/rock has been placed/found, bearing..... $^{\circ}$ M from Mast/Plug/Pillar
5. A.....set in conc/rock has been placed/found, bearing..... $^{\circ}$ M from Mast/Plug/Pillar
6. A.....set in conc/rock has been placed/found, bearing..... $^{\circ}$ M from Mast/Plug/Pillar
7. A.....set in conc/rock has been placed/found, bearing..... $^{\circ}$ M from Mast/Plug/Pillar
8. Action required: *No marks found. Station is of little value.*

STANDPOINT:


Mark	Direction	Horiz. Distance	Height Difference	Mark	Direction	Horiz. Distance	Height Difference
			above standpt. below				above standpt. below
			above standpt. below				above standpt. below
Prepared by: *[Signature]*

Checked: *[Signature]*

Noted on U.T.M. Card

SR2738-1

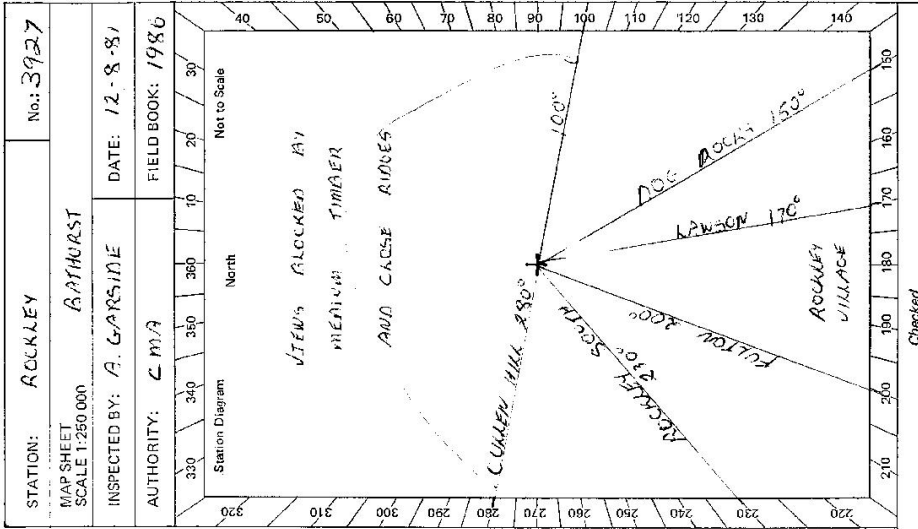


STATION: ROCKLEY No.: 3927

MAP SHEET SCALE 1:250 000 BATHURST

INSPECTED BY: A. GARSIDE DATE: 12-8-81

AUTHORITY: CMA FIELD BOOK: 1986

St 2733 2 D West Government Printer

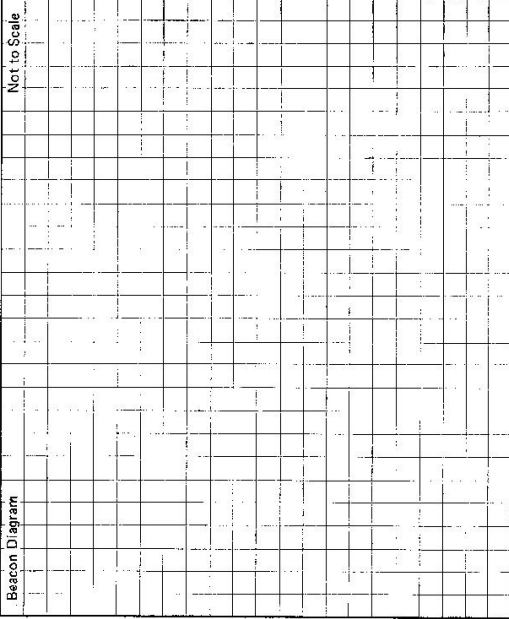Beacon Diagram 	STATION ROCKLEY TS 3927 Owner's Name: MR J. COLSAY Address: MCCOMBS RD HILVIEW GARDENS RD. ROCKLEY Phone: ROCKLEY 3 Current Occupant: Address: Phone: ACCESS 12-8-1981 Access Report of 21/8/1981 was found suitable. Feature DO ROCKLEY RD HEAD TOWARDS EASTWARD TURN HARD RIGHT THROUGH IRON GATE OWNER LIVES IN BRICK HOUSE ON RHS 400M FURTHER ON IRON GATE USER LEFT 1.55 PASS HAYSHED 1.7 PASS HOUSE ON LEFT 1.85 DOUBLE IRON GATES. DRIVE TO LEFT OF YARDS. TOWARDS FENCE CORNER 2.05 IRON GATE. DRIVE BETWEEN FENCES 2.15 USER LEFT TOWARDS LONG TRACK THEN HEAD RIGHT ALONG SHEEP TRACKS AND UP SPUR TO SMALL BOLD KAOLA 2.55 ROCKLEY C.S.	Record of Station Date Date Date
This section to be completed by officer constructing pillar. Original station mark found/not found. Description of mark: Original beacon found/not found. Description of beacon: Height Top of Vanes to Top Markm. Height of mark:m. above G.L. below Diameter of Vanesm. Height of Cairnm. Original Beacon has/not been destroyed by me.		