

CENTRAL MAPPING AUTHORITY


GEODETIC STATION RECONNAISSANCE and MAINTENANCE REPORT

STATION: **ROCKY G.S.** No.: **3935**

MAP SHEET SCALE 1:250 000 **GOUJIBURN**

INSPECTED BY: **P. CARR** DATE: **9-3-78**

AUTHORITY: **CENTRAL MAPPING** FIELD BOOK: **AB 1635**

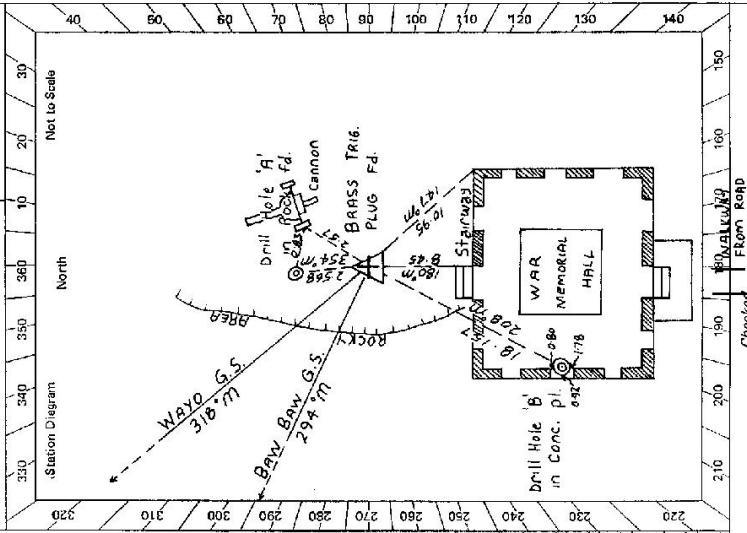

- Description:
- Cleared by lanes bearing..... **300°**..... **VISIBLY**..... from Trig. Mast
  - Mast & Vanes have been painted white & black respectively.
  - The station/pillar was unpiled/not unpiled/constructed on..... **18**....., dimensions now being:  
Description of mark..... **BRASS PLATE**..... should be explicit, e.g., S/Steel Pillar Plate, Steel plug, Brass plug, Bolt, G.I. Pipe  
Height of mark..... **1.1**.....m. above rock/concrete; Mark is.....m. above G.L.
  - Height of Top Vanes to Top Mark/Pillar plate.....m. Diameter of Vanes (vertical).....m.
  - Height of Cairn.....m. Diameter of Cairn.....m. Name Plate found/not found/placed.
  - Length of Mast.....m. (approximate if not unpiled)
  - A. **DRILL HOLE 'A'**..... set in **conc/rock** has been **placed**/found, bearing..... **354°** M from **Mast/Plug/Pillar**
  - A. **DRILL HOLE 'B'**..... set in **conc/rock** has been **placed**/found, bearing..... **208°** M from **Mast/Plug/Pillar**
  - A..... set in **conc/rock** has been placed/round, bearing.....° M from **Mast/Plug/Pillar**
  - A..... set in **conc/rock** has been placed/round, bearing.....° M from **Mast/Plug/Pillar**

Action required:.....

STANDPOINT: **TRIG PLUG** \* See workbook for co ordinates

Mark	Direction	Horiz. Distance	Height Difference	Mark	Direction	Horiz. Distance	Height Difference
RAW BAW G-S	0° 00' 00"		above standpt.				above standpt.
WAXYO G-S	23° 36' 20"		above standpt.				above standpt.
DRILL HOLE 'A'	62° 25'	2.568	below standpt.				below standpt.
DRILL HOLE 'B'	273° 54' 00"	18.157	above standpt.				above standpt.
			below standpt.				below standpt.
			above standpt.				above standpt.
			below standpt.				below standpt.
			above standpt.				above standpt.
			below standpt.				below standpt.

Prepared by: **Robert Tomlinson** 24-11-78 Checked: **Abn. Woodcock** 24-11-78. *Noted on U.T.M. Card*

CENTRAL MAPPING AUTHORITY

GEODETIC SURVEY OF N.S.W.

GEODETIC STATION RECONNAISSANCE and MAINTENANCE REPORT

- Description:
- Note: Cross out word or words which do not apply
- Cleared by lanes bearing..... from Trig. Mast
  - Mast & Vanes have been painted white & black respectively.
  - The station/pillar was unpiled/not unpiled/constructed on..... 19....., dimensions now being:  
Description of mark.....should be explicit, e.g., Steel Pillar Plate, Steel plug, Brass plug, Bolt, G.I. Pipe  
Height of mark.....m. <sup>above</sup> rock/concrete; Mark is .....m. <sup>above</sup> G.L.  
Height of Top Vanes to Top Mark/Pillar plate .....m. Diameter of Vanes (vertical).....m.  
Height of Cairn.....m. Diameter of Cairn.....m. Name Plate found/not found/placed.  
Length of Mast.....m. (approximate if not unpiled)
  - A.....set in conc/rock has been placed/found, bearing.....° M from Mast/Plug/Pillar
  - A.....set in conc/rock has been placed/found, bearing.....° M from Mast/Plug/Pillar
  - A.....set in conc/rock has been placed/found, bearing.....° M from Mast/Plug/Pillar
  - A.....set in conc/rock has been placed/found, bearing.....° M from Mast/Plug/Pillar
  - Action required:.....

STANDPOINT:.....**Goulburn**.....  
1:25,000

Mark	Direction	Horiz. Distance	Height Difference	Mark	Direction	Horiz. Distance	Height Difference
			above standpt.				above standpt.
			below				below
			above standpt.				above standpt.
			below				below
Prepared by:.....  
Checked:.....  
Noted on U.T.M. Card

St 2738-1

STATION: **ROCKY** No.: TS **3935**

MAP SHEET SCALE 1:250 000 **Goulburn**

INSPECTED BY: **A. Sivertsen** DATE: **9-10-78**

AUTHORITY: **CMA** FIELD BOOK: **1709**

Station Diagram

North

330 340 350 360 370 380 390 400

220 230 240 250 260 270 280 290 300 310 320

140 150 160 170 180 190 200 210 220

Not to Scale

Plug found No beacon  
↳ large cannon next to plug  
∴ cannot be beaconed

Sight to south blocked by war memorial

On lower hill than GRAY  
Recommended for Relegation

+

Checked



STATION TS 3935 (ROCKY)

Current Occupant.....

Address.....

Owners Name.....


Address.....

Access

Station Diagram

Not to Scale


North

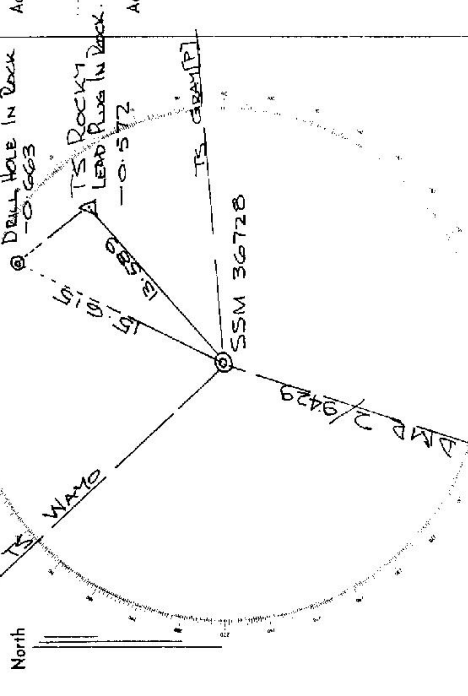

List of Observed Directions:- ~~P801~~ SUMMARY 765/19


Standpoint: SSM 36728

Station	Direction	Station	Direction
DMP 2/9429	198 00 00		
TS WAMO	86 46 50		
TS MT GRAY (P)	85 07 10		
DRILL HOLE	80 21 18		
TRIG PUG	86 31 57		
Station	Direction	Station	Direction

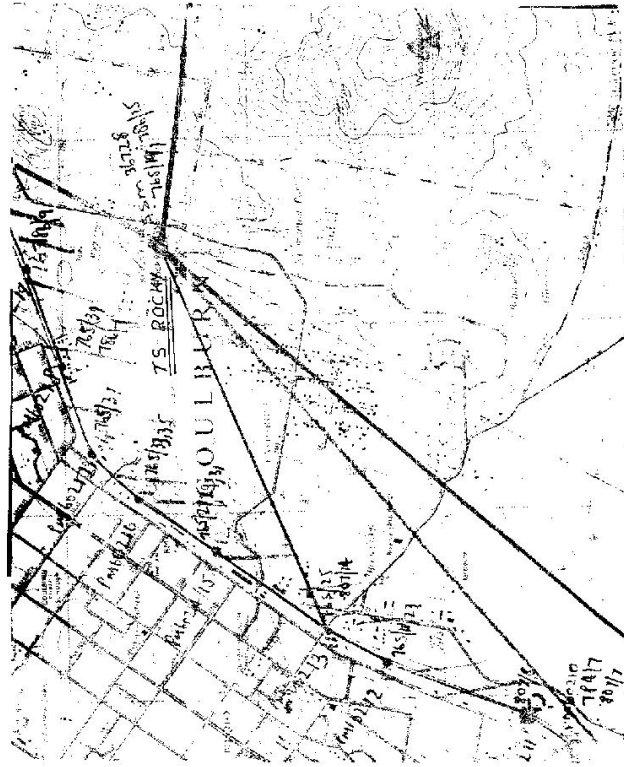

D. West. Government Printer, New South Wales - 1976

GS

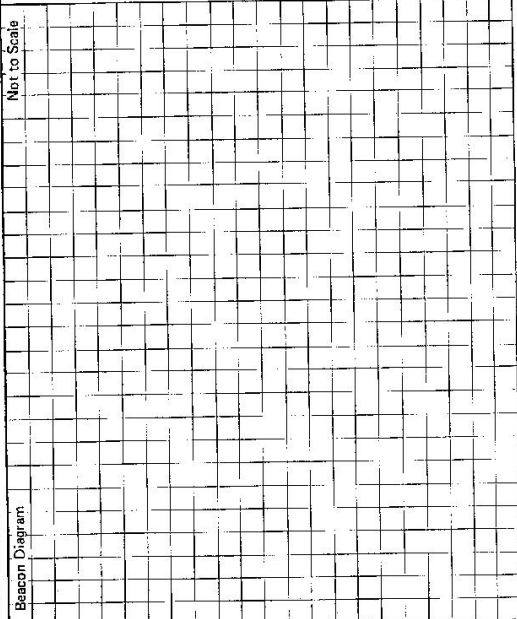St 2733-2 D. West, Government Printer Beacon Diagram	STATION <b>ROCKY</b> TS <b>3935</b>	Owner's Name: <b>Goulburn Municipal Council</b> Address: <b>Town Hall</b> <b>Auburn St Goulburn</b> Phone: <b>(048) 211444</b>  Current Occupant: ..... Address: ..... Phone: .....  ACCESS Access Report of 1/10/1878 was found suitable/unsuitable. From Goulburn Ry station take SLANEY ST south-west then turn left under railway & follow signs to memorial.
Not to Scale 		
This section to be completed by officer constructing pillar. Original station mark found/not found.		
Description of mark: ..... Original beacon found/not found.		
Description of beacon: ..... Height Top of Vanes to Top Mark: .....m. Height of mark: .....m. above rock/conc .....m. below G.L. Diameter of Vanes: .....m. Height of Cairn .....m. Original Beacon has/has not been destroyed by me.		
	Date	Record of Station
	.....	.....
	.....	.....
	.....	.....