

GEODETIC SURVEY OF N.S.W.

CENTRAL MAPPING AUTHORITY

GEODETIC STATION RECONNAISSANCE and MAINTENANCE REPORT

STATION: **Rocky Point** No.: **N 3939**

MAP SHEET SCALE 1:250 000 **CANBERRA**

INSPECTED BY: **H.C. BOEDER** DATE: **9-12-78**

AUTHORITY: **C.M.A.** FIELD BOOK: **01411**

Description:

1. Cleared by lanes bearing **Small white trees are around.** from Trig. Mast
Sign to: Ebbenden Hill, Red Hill or, Summit of Purman Ridge, ST George and Seary Gap area, underlying point.

2. Mast & Vanes have been painted white & black respectively.

3. The station/pillar was ~~erected~~ **not unpiled/constructed on** 19 dimensions now being:

Description of mark should be explicit, e.g., S/Steel Pillar Plate, Steel plug, Brass plug, Bolt, G.I. Pipe

Height of mark m. above rock/concrete; Mark is m. above G.L.

Height of Top Vanes to Top Mark/Pillar plate m. Diameter of Vanes (vertical) m.

Height of Cairn m. Diameter of Cairn m. Name Plate found/not found/placed.

Length of Mast m. (approximate if not unpiled)

4. A set in conc/rock has been placed/found, bearing ° M from Mast/Plug/Pillar

5. A set in conc/rock has been placed/found, bearing ° M from Mast/Plug/Pillar

6. A set in conc/rock has been placed/found, bearing ° M from Mast/Plug/Pillar

7. A set in conc/rock has been placed/found, bearing ° M from Mast/Plug/Pillar

8. Action required: **not a good site for a conc. pillar, because of boulders. R.T.B. on a boulder.**

STANDPOINT:

Mark	Direction	Horiz. Distance	Height Difference	Mark	Direction	Horiz. Distance	Height Difference
			above standpt.				above standpt.
			below				below
			above standpt.				above standpt.
			below				below
Prepared by: **H.C. Boeder** Checked: **Noted on U.T.M. Card**

Sr. 2732-2 D. West, Government Printer

STATION Rocky Point TS 3939

Owner's Name: **NOT KNOWN** Current Occupant:


Address: Address:

Phone: Phone:

ACCESS

Access Report of 12/19/18 was found suitable/unusable.
 from Cross roads at Bungahere. Gullburn - Quarantyne - Gundaroo

take the Gullburn road towards Garage
 passing Mt. Fairy road on R.H.S at 0.00km
 turn off Gullburn road, take road on L.H.S at 14.90
 follows this road to road turn off on L.H.S at 18.70
 (Sign BUNGAREE 33 - Gullburn 48) 31.10
 take this road on L.H.S + follow till reaching a homestead
 owner? on R.H.S at 34.50,
 passing homestead turn into track on R.H.S, through gate, 34.80,
 follow track through gate and through gate again at, 35.00
 following track + through another gate at, 35.30.
 through another gate and going straight west at, 35.60
 through fence (down) and still going west at, 36.20
 through gate on R.H.S at, 36.50
 passing fence + gate at, 37.10
 through opening of fence at, 37.60

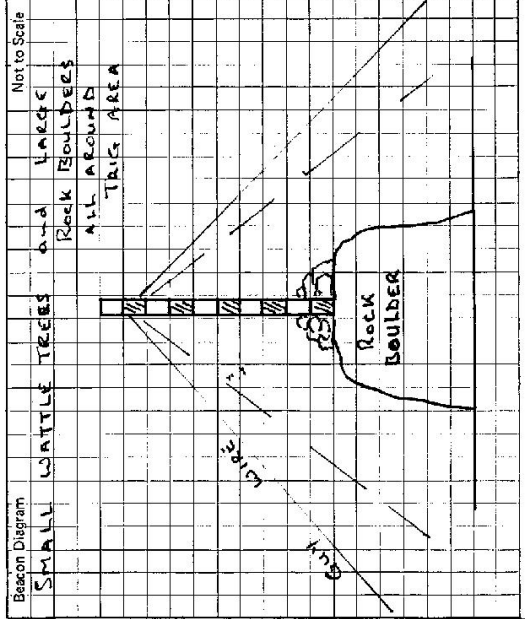

This section to be completed by officer constructing pillar.

Original station mark found/not found.

Description of mark:

Original beacon found/net found.

Description of beacon: **Round Mast, guy wire down Mast**

Height Top of Mast to Top Mark: m. above below G.L.

Height of mark: m. above below G.L.

Diameter of Vanoes: 115 mm. Height of Cairn: m.

Original Beacon has/has not been destroyed by me.

Date	Record of Station
	end of drive at over fence and walk through rocks and around boulders to 2 mile walk.
	37.80