

GEODETIC SURVEY OF A.S.W.

CENTRAL MAPPING AUTHORITY

GEODETIC STATION RECONNAISSANCE and MAINTENANCE REPORT

Description:

Note: Cross out word or words which do not apply

1. Cleared by lances bearing..... N.A..... from Trig. Mast
2. Mast & Vanes have been painted white & black respectively.
3. The station/pillar was unpiled/not unpiled/constructed on..... N.A..... 19....., dimensions now being:
  - Description of mark..... N.A..... should be explicit, e.g., S/Steel Pillar Plate, Steel plug, Brass plug, Bolt, G.I. Pipe
  - Height of mark..... N.A..... m. above rock/concrete; Mark is..... N.A..... m. above G.L.
  - Height of Top Vanes to Top Mark/Pillar plate ..... N.A..... m. Diameter of Vanes (vertical)..... N.A..... m.
  - Height of Cairn..... N.A..... m. Diameter of Cairn..... N.A..... m. Name Plate found/not found/placed. N.A.
  - Length of Mast..... N.A..... m. (approximate if not unpiled)
4. A..... N.A..... set in conc/rock has been placed/found, bearing..... ° M from Mast/Plug/Pillar
5. A..... N.A..... set in conc/rock has been placed/found, bearing..... ° M from Mast/Plug/Pillar
6. A..... N.A..... set in conc/rock has been placed/found, bearing..... ° M from Mast/Plug/Pillar
7. A..... N.A..... set in conc/rock has been placed/found, bearing..... ° M from Mast/Plug/Pillar
8. Action required:..... Setting up of new mark and re-establishing original

STANDPOINT:


Mark	Direction	Horiz. Distance	Height Difference	Mark	Direction	Horiz. Distance	Height Difference
			above standpt.				above standpt.
			below				below
			above standpt.				above standpt.
			below				below
Prepared by: D. HALLS

Checked: 12/9/77

Noted on U.T.M. Card

SI 2753-1

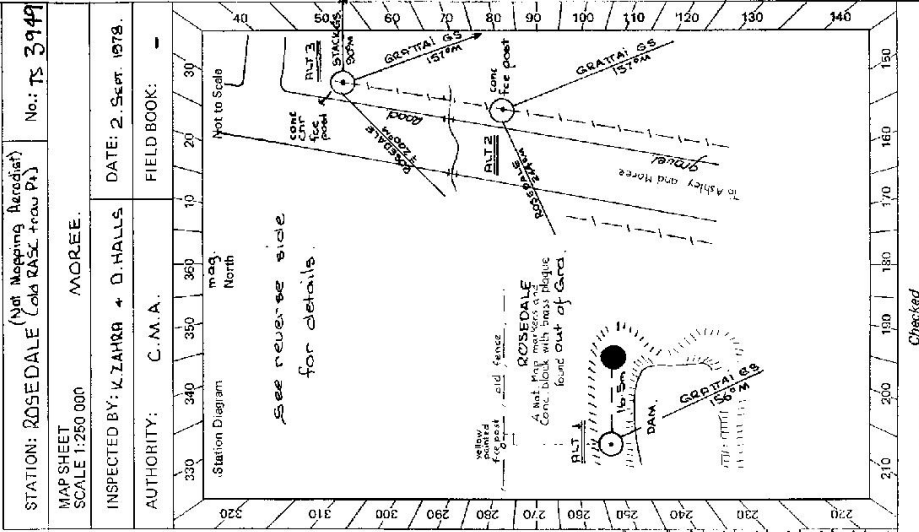

Sr 2733-2 D. West, Government Printer

Sr 2733-2 D. West, Government Printer Beacon Diagram	Not to Scale 	STATION <b>ROSEDALE</b> (Nat. Rep Aerodict 4th and old army town Pt.) TS <b>2944</b>	Owner's Name: ..... Address: ..... Phone: ..... Current Occupant: ..... Address: ..... Phone: ..... ACCESS Access Report of <u>29/01/1978</u> was found suitable/unsuitable.	Alternative 1. is situated on top of dam wall 16.5m west of the original station. From this point Grattai G.S. is visible. This point however is still subject to the original problems of Rosedale, that the dam wall is subject to severe erosion. Position was not marked.  Alternative 2. is situated 200m north of the original station on the eastern side of the road. It is a concrete fence post and has visibility to Grattai G.S. It is also a much more stable position than the original.  Alternative 3. is another concrete fence post actually a corner post. It is 200m north of the original station and again on the eastern side of the road and has visibility to both Grattai G.S. and Stack G.S. This is probably the most suitable position if a new position is warranted.	Record of Station Date ..... ..... .....
This section to be completed by officer constructing pillar. Original station mark found/not found. Description of mark: ..... Original beacon found/not found. Description of beacon: ..... Height Top of Vanes to Top Mark .....m. Height of mark .....m. above below rock/conc .....m. above below G.L. Diameter of Vanes .....m. Height of Cairn .....m. Original Beacon has/has not been destroyed by me.					