


TS395

TS395 CMA 5-010

Locality: Morundah

LGA: Urana

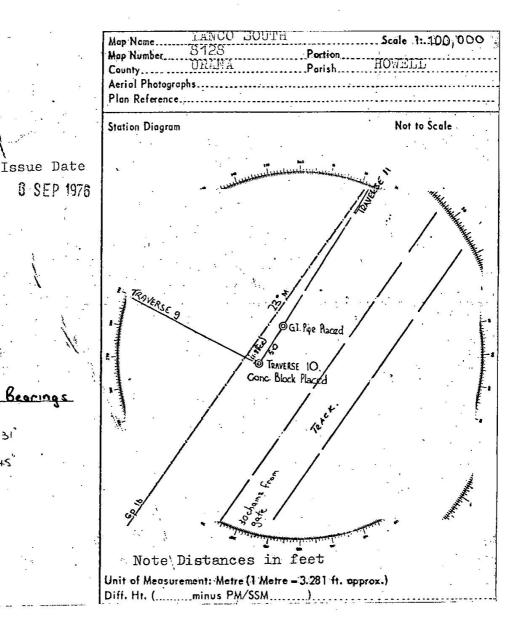

Observed Bearings

TRAVERSE 9: 294 18 31 PRAVERSE 11.