

CENTRAL MAPPING AUTHORITY

GEODETIC SURVEY OF M.S.W.  
 GEODETIC STATION RECONNAISSANCE and MAINTENANCE REPORT

STATION: **ROSS** No: **TS 3953**

MAP SHEET SCALE 1:250 000 **Gaulburn**

INSPECTED BY: **A. Sivertsen** DATE: **21-11-78**

AUTHORITY: **CMA** FIELD BOOK: **1717**


- Description:
1. Cleared by lanes bearing..... from Trig. Mast
  2. Mast & Vanes have been painted white & black respectively.
  3. The station/pillar was unpiled/not unpiled/constructed on.....19....., dimensions now being: Description of mark.....should be explicit, e.g., S/Steel Pillar Plate, Steel plug, Brass plug, Bolt, G.I. Pipe Height of mark.....m. above rock/concrete; Mark is.....m. above G.L.
  4. A..... Diameter of Vanes (vertical).....m.
  5. A..... Diameter of Cairn.....m. Name Plate found/not found/placed.
  6. A..... Length of Mast..... (approximate if not unpiled)
  7. A..... set in conc/rock has been placed/found, bearing.....° M from Mast/Plug/Pillar
  8. A..... set in conc/rock has been placed/found, bearing.....° M from Mast/Plug/Pillar
  9. A..... set in conc/rock has been placed/found, bearing.....° M from Mast/Plug/Pillar
  10. A..... set in conc/rock has been placed/found, bearing.....° M from Mast/Plug/Pillar

STANDPOINT: **TARALGA**  
 1:25,000

Mark	Direction	Horiz. Distance	Height Difference	Mark	Direction	Horiz. Distance	Height Difference
			above standpt.				above standpt.
			below				below
			above standpt.				above standpt.
			below				below
Prepared by: *[Signature]* Checked: *[Signature]* Noted on U.T.M. Card

St 2733-1

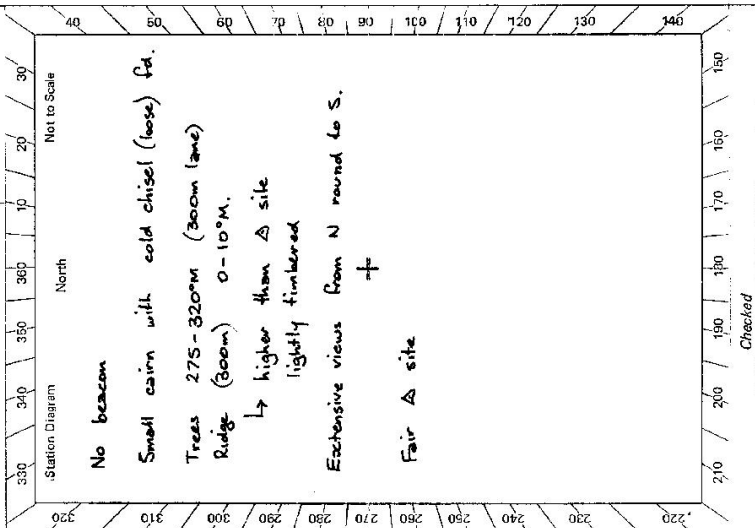

Checked



GEODETTIC SURVEY OF A.S.W.

CENTRAL MAPPING AUTHORITY

GEODETTIC STATION RECONNAISSANCE and MAINTENANCE REPORT

- Description: *Note: Cross out word or words which do not apply*
- Cleared by lanes bearing..... *328° - 55.4 m, 233° - 43.9 m, 106° - 112 m, from Trig. Mast 118 - 151 m, 155 - 275 m.*
  - Mast & Vanes have been painted white & black respectively. *X No Beacon at Station.*
  - The station/pillar was unpiled/not unpiled/constructed on..... *19....., dimensions now being:*  
Description of mark..... *SCIL* should be explicit, e.g., S/Steel Pillar Plate, Steel plug, Brass plug, Bolt, G.I. Pipe  
Height of mark..... *0.5 m* above *SCIL* rock/concrete; Mark is..... *M* m. above G.L.
  - Height of Top Vanes to Top Mark/Pillar plate..... m. Diameter of Vanes (vertical)..... m.  
Height of Cairn..... m. Diameter of Cairn..... m. Name Plate *found/not found/placed.*
  - Length of Mast..... m. (approximate if not unpiled)
  - A..... set in conc/rock has been placed/found, bearing..... °M from Mast/Plug/Pillar
  - A..... set in conc/rock has been placed/found, bearing..... °M from Mast/Plug/Pillar
  - A..... set in conc/rock has been placed/found, bearing..... °M from Mast/Plug/Pillar
  - A..... set in conc/rock has been placed/found, bearing..... °M from Mast/Plug/Pillar
  - Action required:.....

STANDPOINT:		STANDPOINT:		STANDPOINT:	
Mark	Direction	Horiz. Distance	Height Difference	Mark	Direction
			above standpt		
			below		
			above standpt		
			below		
Prepared by: *D. J. Kain* Checked: *Noted on U.T.M. Card*

