

CENTRAL MAPPING AUTHORITY

GEODETIC SURVEY OF N.S.W.

GEODETIC STATION RECONNAISSANCE and MAINTENANCE REPORT

Description:

1. Cleared by lanes bearing..... CLEARED 360° ..... from Trig. Mast  
 Note: Cross out word or words which do not apply
2. Mast & Vanes have been painted white & black respectively.
3. The station/pillar was unpiled/constructed on..... 2.4 - 8 - 1981....., dimensions now being:  
 Description of mark..... should be explicit, e.g., S/Steel Pillar Plate, Steel plug, Brass plug, Bolt, G.I. Pipe  
 Height of mark.....<sup>above</sup>.....<sup>below</sup>.....m. rock/concrete; Mark is.....<sup>above</sup>.....<sup>below</sup>.....m. G.L.  
 Height of Top Vanes to Top Mark/Pillar plate .....m. Diameter of Vanes (vertical).....m.  
 Height of Cairn.....2.0.....m. Diameter of Cairn.....2.0.....m. Name Plate found/not found/placed.  
 Length of Mast .....m. (approximate if not unpiled)  
 MAST + VANES LYING ON GROUND  
 4. A..... set in conc/rock has been placed/ found, bearing.....° M from Mast/Plug/Pillar  
 5. A..... set in conc/rock has been placed/ found, bearing.....° M from Mast/Plug/Pillar  
 6. A..... set in conc/rock has been placed/ found, bearing.....° M from Mast/Plug/Pillar  
 7. A..... set in conc/rock has been placed/ found, bearing.....° M from Mast/Plug/Pillar


8. Action required: OK TO CONSTRUCT PILLAR STATION HOWEVER OF LITTLE VALUE  
BIG BOX IS A BETTER STATION

STANDPOINT:

Mark	Direction	Horiz. Distance	Height Difference	Mark	Direction	Horiz. Distance	Height Difference
			above standpt.				above standpt.
			below standpt.				below standpt.
			above standpt.				above standpt.
			below standpt.				below standpt.
Prepared by: Bathurst 14/10/88 Checked: Noted on U.T.M. Card

Sr 2793-1

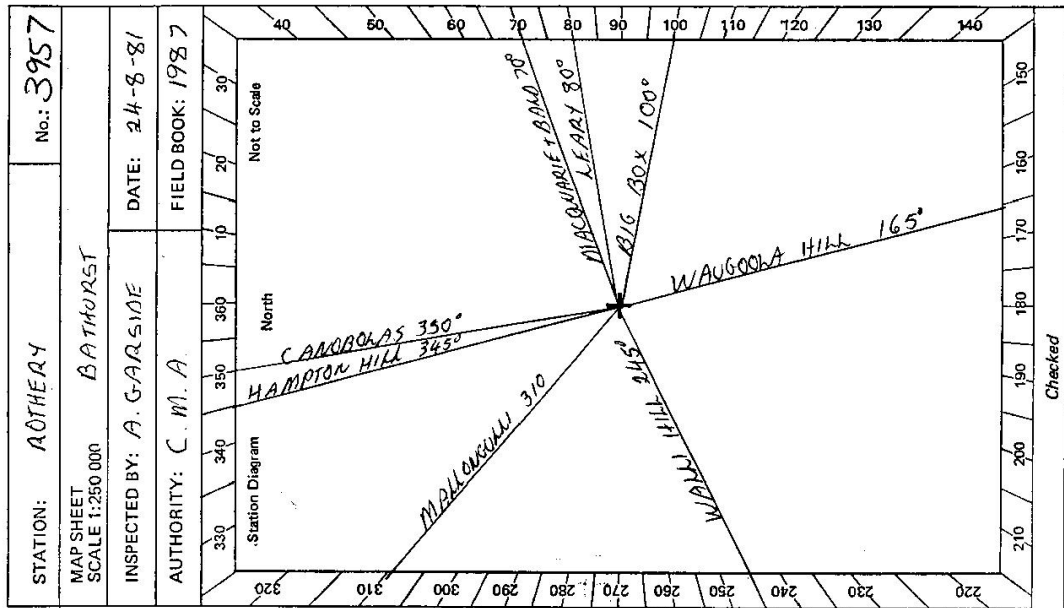

STATION: ROTHEY No.: 3957

MAP SHEET SCALE 1:250 000 BATHURST


INSPECTED BY: A. GARSIDE DATE: 24-8-81

AUTHORITY: C. M. A. FIELD BOOK: 1987

Checked

G:

BS 2733-2 D. West, Government Printer

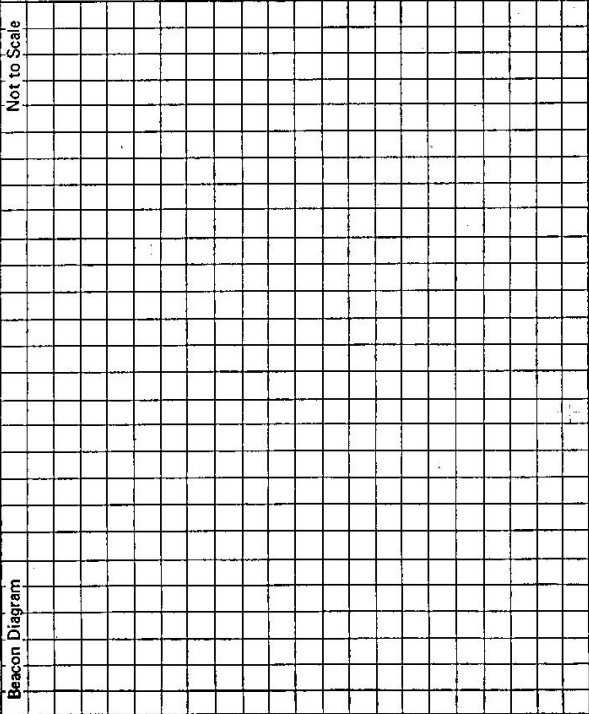Beacon Diagram 	<p style="text-align: center;"><b>STATION</b>      <i>ROTHERY</i>      <b>TS</b> <i>3957</i></p> <p>Owner's Name: <i>SIAM ELDORGE</i>                  Address: <i>"ROTHERY"</i>                  Phone: <i>LYNDHURST 71</i></p> <p>Current Occupant: .....                  Address: .....                  Phone: .....</p> <p style="text-align: center;"><b>ACCESS</b></p> <p>Access Report of <i>24.8.1981</i> was found satisfactory.</p> <p><i>Feature</i>                  0.0 LYNDRIST RD. TAKE ROAD ON RIGHT TO MID WESTERN HWY                  0.45 TURN LEFT ONTO MWH. HEADING SOUTH                  4.5 PASS "DUNLOP" HAYSHED ON LEFT                  5.0 PASS TRACK ON LEFT                  10.7 CROSS LIMESTONE CK.                  11.1 TURN LEFT THROUGH DOUBLE IRON GATES NEAR RED MAILBOX JUST BEFORE FIRE REGS. SIGN. TAKE TRACK TO LEFT OWNERS HOUSE ON RIGHT.                  11.3 PASS SHEDS ON RIGHT.                  11.4 THROUGH IRON GATE ON RIGHT NEXT TO TREE. FOLLOW FENCE                  11.45 TAKE TRACK BACK TO RIGHT AT FENCE CORNER                  11.5 CROSS CK ABOVE DAM                  11.55 MAKE OWN WAY UP HILL ON LEFT.                  12.15 ROTHERY GS JUST OVER FENCE</p>	Record of Station          
This section to be completed by officer constructing pillar. Original station mark found/not found. Description of mark: ..... Original beacon found/not found. Description of beacon: ..... Height Top of Vanes to Top Mark .....m. Height of mark .....m. above rock/conc .....m. below G.L. Diameter of Vanes .....m. Height of Cairn .....m. Original Beacon has/has not been destroyed by me.		Date     