

CENTRAL MAPPING AUTHORITY

Topographical Survey of N.S.W.

Department of Lands

RECONNAISSANCE and MAINTENANCE REPORT

STATION **Hume**

ROUND **TS 3959**

This Trig. Station has been:-

Note: Cross out word or words which do not apply

1. Completely cleared to permit 360° vision to surrounding Trigs.
2. Cleared by lanes bearing from Trig. Mast
3. Trig. Mast & Vanes have been painted white & black respectively.
4. The Trig. was unpiled/not unpiled, dimensions now being: of station Mark found / not found

Description of mark should be explicit, e.g. Steel plug, Brass plug, Balr, G.L. Pipe

Height of mark m above below rock/concrete m above below G.L.

Height of Top Vanes to Top Mark m. Diameter of Vanes (vertical) m.

Height of Cairn m. Diameter of Cairn m.

Length of Mast m. (approximate if not unpiled)

5. A. set in conc/rock has been placed. m. bearing °M from Trig. Mast

6. A. set in conc/soil has been placed. m. bearing °M from Trig. Mast

7. A. set in conc/soil has been placed. m. bearing °M from Trig. Mast

8. A. set in conc/rock has been placed. m. bearing °M from Trig. Mast

9. Connection to m. bearing °M

10. Connection to m. bearing °M

11. Connection to m. bearing °M


12. Connection to m. bearing °M

13. Diff. Ht. is m. above below

14. Diff. Ht. is m. above below

15. Diff. Ht. is m. above below

16. Diff. Ht. is m. above below

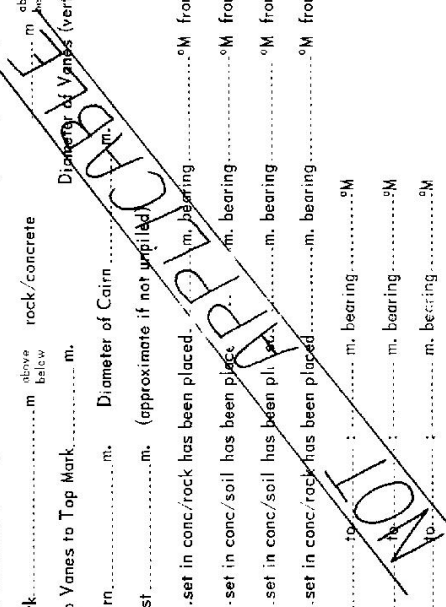

Prepared by: _____

Checked: _____

Noted on U.T.M. Card

Co: _____

Map Sheet: **Holbrook**

Inspected by: **G. Hanna**

Authority: _____

Beacon Diagram: _____ Not to Scale

Ph: _____

No: **8326-N**

Date: **12/10/16**

Field Book: _____

Date: _____

Record of Station

Checked

GEODETTIC SURVEY OF N.S.W.

CENTRAL MAPPING AUTHORITY


GEODETTIC STATION RECONNAISSANCE and MAINTENANCE REPORT

STATION: **ROUND** No.: **3959**
 MAP SHEET SCALE 1:250 000 **WAGGA WAGGA** SCALE 1:100 000 **HOL BROOK**
 INSPECTED BY: **J. Sutton** DATE: **29 Nov 1988**
 AUTHORITY: **CMA** FIELD BOOK: **-**

- Description: *Note: Cross out word or words which do not apply*
1. Cleared by James bearing..... from Trig. Mast
 2. Mast & Vanes have been painted white & black respectively.
 3. The station/pillar was unpiled/not unpiled/constructed on..... 19....., dimensions now being: Description of mark..... should be explicit e.g., S/Steel Pillar Plate **Steel** plug, Brass plug, Bolt, G.I. Pipe
 Height of mark..... m..... above rock/concrete; Mark is..... m..... above G.I.
 Height of Top Vanes to Top Mark/Pillar plate..... m..... Diameter of Vanes (vertical)..... m.
 Height of Cairn..... m..... Diameter of Cairn..... m. Name Plate found/not found/placed.
 Length of Mast..... m..... (approximate if not unpiled)
 4. A..... set in conc/rock has been placed/found, bearing.....° M from Mast/Plug/Pillar
 5. A..... set in conc/rock has been placed/found, bearing.....° M from Mast/Plug/Pillar
 6. A..... set in conc/rock has been placed/found, bearing.....° M from Mast/Plug/Pillar
 7. A..... set in conc/rock has been placed/found, bearing.....° M from Mast/Plug/Pillar
 8. Action required.....

Possible rockspits forming triangle found. No station mark or beacon found.

+

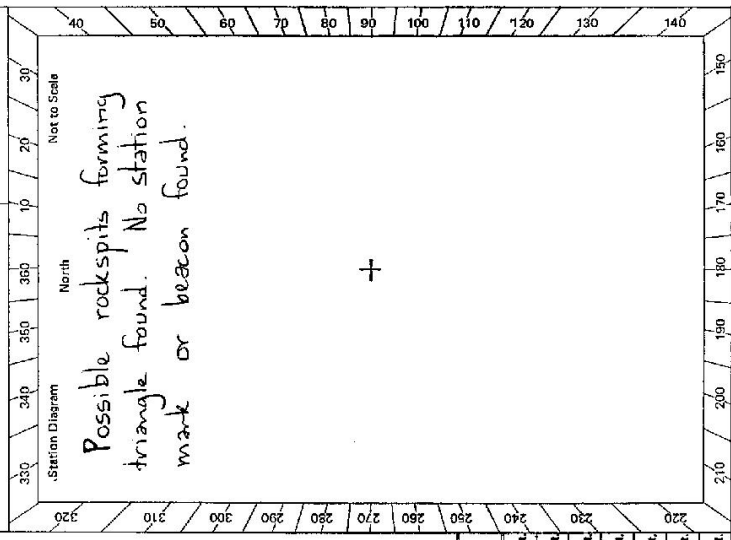

STANDPOINT:							
Mark	Direction	Horiz. Distance	Height Difference	Mark	Direction	Horiz. Distance	Height Difference
			above standpt				above standpt
			below				below
			above standpt				above standpt
			below				below
Prepared by: *J. Sutton* 2.7.89

Checked:

Noted on U.T.M. Card

Checked

\$1.2733-2 D. West Government Printer Beacon Diagram Not to Scale	STATION ROUND TS 3959	Owner's Name: Address: Phone: Current Occupant: Address: Phone: ACCESS Access Report of 29/11/1988 was found suitable/unsuitable.	
This section to be completed by officer constructing pillar. Original station mark found/not found.		Description of mark: Original beacon found/not found.	
Description of beacon: Height Top of Vanes to Top Mark m. Height of mark m. above G.L. below m.		Diameter of Vanes m. Height of Cairn m. Original Beacon has/has not been destroyed by me.	
Date		Record of Station	