


CENTRAL MAPPING AUTHORITY

GEODETIC SURVEY OF N.S.W.

GEODETIC STATION RECONNAISSANCE and MAINTENANCE REPORT

STATION: **ROUND** No.: **3960**

- Description: **360° Vision**
 Note: *Cross out word or words which do not apply*
1. Cleared by lens bearing **360° Vision** from Trig. Mast
 2. Mast & Vanes have been painted white & black respectively.
 3. The station/pillar was unpiled/~~not unpiled~~/~~constructed~~ on **Steel Pipe**, dimensions now being: **19**.....m.
- Description of mark: **Steel Pipe** should be explicit, e.g., S/Steel Pillar Plate, Steel plug, Brass plug, Bolt, G.I. Pipe
- Height of mark: **0.77** m. ^{above} rock/concrete; Mark is **1.0** m. ^{above} G.L.
- Height of Top Vanes to Top Mark/~~Plate~~ **1.865** m. Diameter of Vanes (vertical) **0.3** m.
- Height of Cairn: **TRIPOD** m. Diameter of Cairn:m. Name Plate ~~found~~/~~not found~~/~~replaced~~.
- Length of Mast:m. (approximate if not unpiled)
4. **Star Picket** set in conc/rock has been placed/~~found~~, bearing **182**° M from Mast/Plug/Pillar
 5. **A** set in conc/rock has been placed/~~found~~, bearing° M from Mast/Plug/Pillar
 6. **A** set in conc/rock has been placed/~~found~~, bearing° M from Mast/Plug/Pillar
 7. **A** set in conc/rock has been placed/~~found~~, bearing° M from Mast/Plug/Pillar
8. Action required:

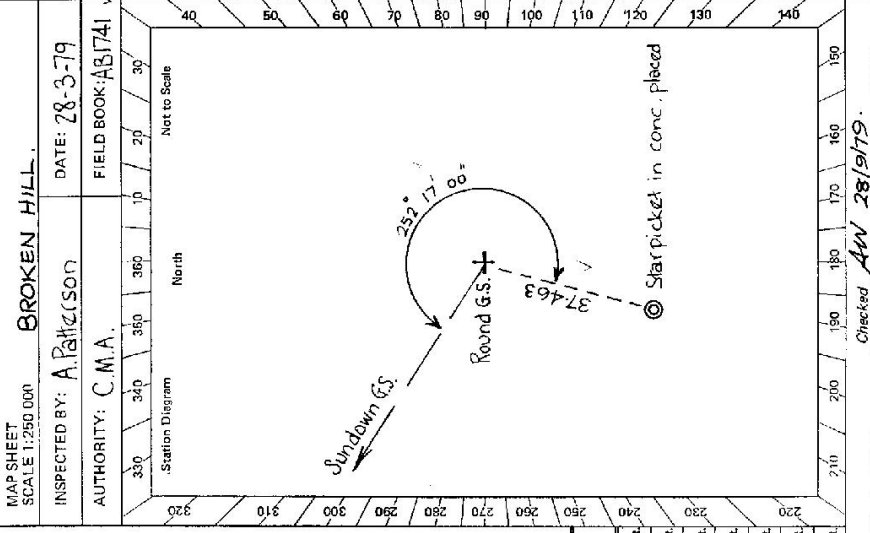

STANDPOINT: **STEEL PIPE IN CONC.**

Mark	Direction	Horiz. Distance	Height Difference	Mark	Direction	Horiz. Distance	Height Difference
SUN-DOWN G.S.	00° 00' 00"		above standpt.				above standpt.
STAR-PICKET IN CONC.	252° 16' 57"	37.443	below standpt.				below standpt.
			above standpt.				above standpt.
			below standpt.				below standpt.
			above standpt.				above standpt.
			below standpt.				below standpt.
			above standpt.				above standpt.
			below standpt.				below standpt.
			above standpt.				above standpt.
			below standpt.				below standpt.

Prepared by: **A. Paterson** 5/7/19 Checked: **AW 28/9/19**

Noted on U.T.M. Card **12 9**


G

STATION **ROUND** **rs 3960**

Owner's Name:
 Address:
 Phone:
 Current Occupant:
 Address:
 Phone:

ACCESS

Access Report of 28.3.1979 was found suitable/.....
 0.0 Broken Hill P.O head east along Argent St
 toward Wilcannia
 5.1 Just after crossing (dry) creek turn left
 onto gravel road signposted "Silver Peak"
 6.0 turn right - over pipeline & head up gravel track up ridge
 6.8 Round G.S at top of hill. ✓
 J. Robertson 31/19

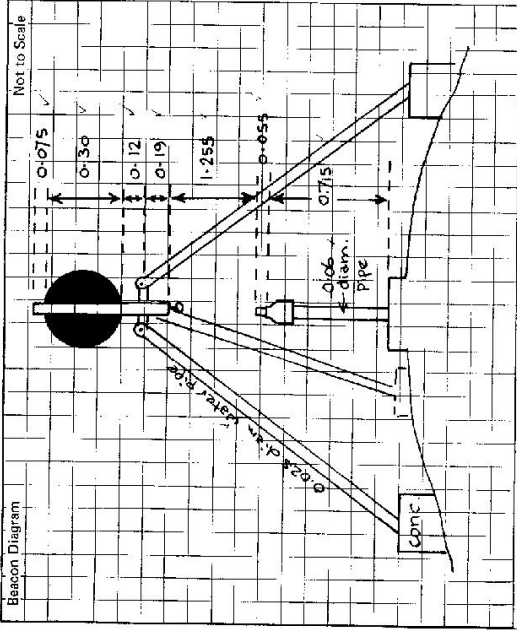

This section to be completed by officer constructing pillar.

Original station mark found/not found.

Description of mark:

Original beacon found/not found.

Description of beacon:

Height Top of Vanes to Top Mark:m.

Height of mark:m. above G.L. below

Diameter of Vanesm. Height of Cairnm.

Original Beacon has/has not been destroyed by me.

Date	Record of Station

Department of Lands
 STATION TS 3960 (ROUND)
 Co: YANCOMINWA Ph: BOLAIWA
 Map Sheet: SALANGAN 1:100,000 No: 7234
 Inspected by: R. BENJAMIN Date: 13TH JULY 1980
 Authority: INVESTIGATION SURVEYS Field Book: NY 1568/63


RECONNAISSANCE and MAINTENANCE REPORT

This Trig. Station has been: Note: Cross out word or words which do not apply

1. Completely cleared to permit 360° vision to surrounding trigs. ✓
2. Cleared by lances bearing from Trig. Mast
3. Trig. Mast & Vanes have been painted white & black respectively. No
4. The Trig. was unpiled/not unpiled, dimensions now being:
 - Description of mark: CONCRETE should be explicit, e.g. Steel plug, Brass plug, Bolt, Concrete Pillar
 - Height of mark: 0.775 m ^{above} rock concrete _{below} G.L.
 - Height of Top Vanes to Top Mark/Top pillar: 1.865 m Diameter of Vanes (vertical): 0.30 m.
 - Height of Cairn: --- m. Diameter of Cairn: --- m.
 - Length of Mast: --- m. (approximate if not unpiled) OVERHEAD TRIPOD
5. A --- set in conc/rock has been placed/rd --- m. bearing ---°M from Trig. Mast/pillar
6. 1 STEEL PICKET set in conc/soil has been placed/rd 2.833 m. bearing 296°M from Trig. Mast/pillar
7. 2 STEEL PICKET set in conc/soil has been placed/rd 3.601 m. bearing 174°M from Trig. Mast/pillar
8. A --- set in conc/rock has been placed/rd --- m. bearing ---°M from Trig. Mast/pillar

9. Connection --- to --- m. bearing ---°M
10. Connection --- to --- m. bearing ---°M
11. Connection --- to --- m. bearing ---°M
12. Connection --- to --- m. bearing ---°M
13. Diff. Ht. STEEL PICKET 1 is 1.350 m. ^{above} --- _{below} ---
14. Diff. Ht. STEEL PICKET 2 is 1.192 m. ^{above} --- _{below} ---
15. Diff. Ht. --- is --- m. ^{above} --- _{below} ---
16. Diff. Ht. --- is --- m. ^{above} --- _{below} ---

Prepared by: Agustin Checked by: Subanon 2/10/80

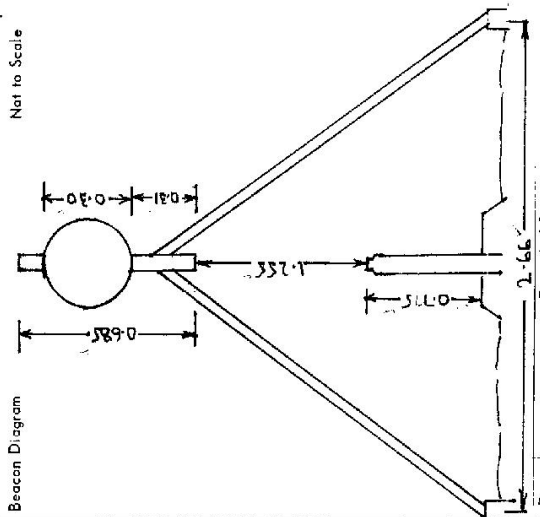

Date _____
 Record of Station _____

Page 1 of 2

GEODETTIC SURVEY OF NSW

CENTRAL MAPPING AUTHORITY


GEODETTIC STATION RECONNAISSANCE and MAINTENANCE REPORT

STATION: ROUND G.I. PILLAR No.: 3960

MAP SHEETS SCALE 1:100 000
SCALE 1:250 000

INSPECTED BY: P. BOTS DATE: 21/7/90

AUTHORITY: LAND INFORMATION CENTRE FIELD BOOK: C.605

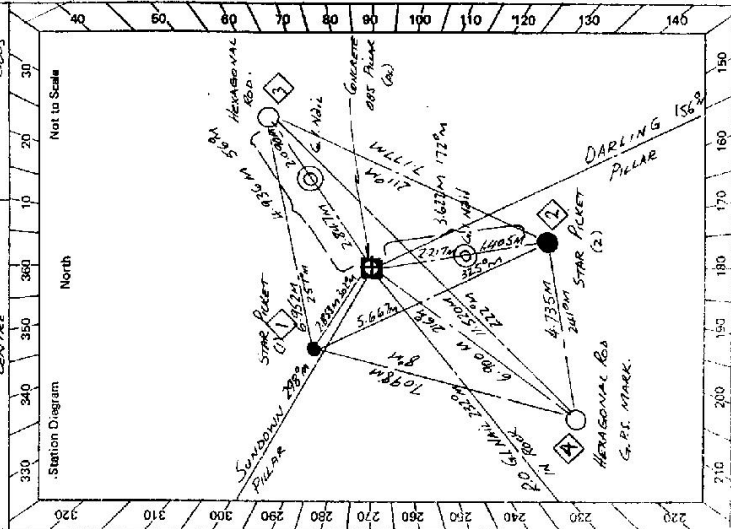

Description:	360°	Note: Cross out word or words which do not apply
1. Cleared by lances bearing.....	360°	from Trig. Mast
2. Mast & Vanes have been painted white & black respectively. ✓		
3. The station/pillar was replaced constructed on 22.44 19.92, dimensions now being:		
Description of mark 3/4 Pillar Plate should be explicit, e.g. S/Steel Pillar Plate, Steel plug, Brass plug, Bolt, G.I. Pipe		
Height of mark 1.375 m. above rock/concrete G.L.		
Height of Top Vanes to Top Mark Pillar plate 1.440 m. Diameter of Vanes (vertical) 0.150 m.		
Height of Cairn NA m. Diameter of Cairn NA m. Name Plate found/not found /placed.		
Length of Mast NA m. (approximate if not unplied)		
4. A STAR PICKET (1) set in conc/rock ^{soil} has been placed /found, bearing 303 °M from Mast/Vane /Pillar		
5. A G.I. PILLAR set in conc/rock ^{soil} has been placed /found, bearing 216 °M from Mast/Vane /Pillar		
6. A STAR PICKET (2) set in conc/rock ^{soil} has been placed /found, bearing 172 °M from Mast/Vane /Pillar		
7. A HEXAGONAL ROD set in conc/rock ^{soil} has been placed /found, bearing 56 °M from Mast/Vane /Pillar		
8. Action required: Placement of Name Plate		

Mark	Direction	Horiz. Distance	Height Difference	Mark	Direction	Horiz. Distance	Height Difference
ED MARK IN ROCK	0 00 00		above	20 MARK IN ROCK	0 00 00		above
SUNDOWN (P)	65 49 10	2807	below	CONCRETE OBS. PILLAR	9 58 40	4.936	1.643
STAR PICKET (1)	166 46 50	2833	below	G.I. PILLAR	9 58 50	2.090	0.055
G.I. PILLAR	191 27 50	2847	below	STAR PICKET (2)	29 33 40	1.952	0.348
HEXAGONAL ROD	191 28 00	4.936	below	SUNDOWN (P)	64 17 00		
DARLING (P)	291 31 20	2.217	below	DARLING (P)	290 03 36		
G.I. MARK	304 35 40	2.217	below	STAR PICKET (1)	242 19 56	7.176	0.886
STAR PICKET (2)	504 35 40	5.622	below	HEXAGONAL ROD	304 44 10	11.621	0.239
HEXAGONAL ROD	344 32 45	6.701	below				
G.I. MARK	367 35 40	1.883	below				

STANDPOINT: CONCRETE OBSERVING PILLAR STANDPOINT: HEXAGONAL ROD

Prepared by: P. BOTS 31/7/90

Checked: G. BOTS 3/8/90

Noted on U.T.M. Card

Checked

S.D. 1407

PAGE 2 of 2

GEODETTIC SURVEY OF A.I.S.W.

CENTRAL MAPPING AUTHORITY

GEODETTIC STATION RECONNAISSANCE and MAINTENANCE REPORT


STATION: *ROUND G.I. PILLAR* No.: *5960*

MAP SHEETS SCALE 1:100 000
SCALE 1:250 000
INSPECTED BY: *P.BETS* DATE: *21/7/90*

AUTHORITY: *LAND INFORMATION CENTRE* FIELD BOOK: *C 665*

Note: *Cross out word or words which do not apply*

1. Cleared by lanes bearing..... from Trig, Mast
2. Mast & Vanes have been painted white & black respectively.
3. The station/pillar was unpiled/not unpiled/constructed on.....¹⁹....., dimensions now being:
 - Description of mark..... should be explicit, e.g., S/Steel Pillar Plate, Steel plug, Brass plug, Bolt, G.I. Pipe
 - Height of mark.....^{above}.....^{below}..... m. above below G.L.
 - Height of Top Vanes to Top Mark/Pillar plate.....m. Diameter of Vanes (vertical).....m.
 - Height of Cairn.....m. Diameter of Cairn.....m. Name Plate found/not found/placed.
 - Length of Mast.....m. (approximate if not unpiled)
4. A..... set in conc./rock has been placed/found, bearing.....° M from Mast/Plug/Pillar
5. A..... set in conc./rock has been placed/found, bearing.....° M from Mast/Plug/Pillar
6. A..... set in conc./rock has been placed/found, bearing.....° M from Mast/Plug/Pillar
7. A..... set in conc./rock has been placed/found, bearing.....° M from Mast/Plug/Pillar
8. Action required:.....

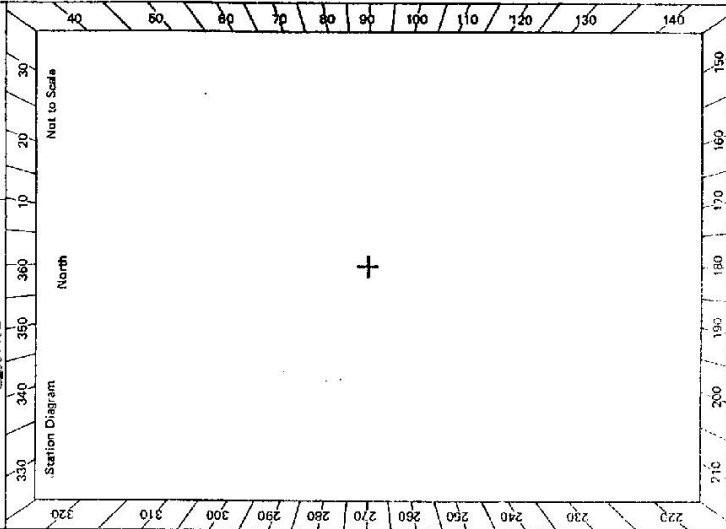

Mark	Direction	Horiz. Distance	Height Difference	Mark	Direction	Horiz. Distance	Height Difference
<i>RO NAIL IN ROCK</i>	<i>0 00 00</i>						
<i>HEXAGONAL ROD (G.P.S.)</i>	<i>25 20 4.735</i>	<i>0.055</i>	<i>below standpt.</i>	<i>RO NAIL IN ROCK</i>	<i>0 00 00</i>		
<i>SUNBOWN (P)</i>	<i>60 17 30</i>		<i>below standpt.</i>	<i>SUNBOWN (P)</i>	<i>61 50 55</i>		
<i>STAR PICKET (1)</i>	<i>93 59 50</i>	<i>5.667</i>	<i>0.164</i>	<i>STAR PICKET (1)</i>	<i>137 12 00</i>	<i>7.098</i>	<i>0.106</i>
<i>G.I. NAIL</i>	<i>119 03 00</i>	<i>1.405</i>	<i>0.210</i>	<i>CONCRETE OBS PILLAR</i>	<i>160 30 40</i>	<i>6.990</i>	<i>1.981</i>
<i>CONCRETE OBS PILLAR</i>	<i>119 02 40</i>	<i>3.622</i>	<i>1.829</i>	<i>HEXAGONAL ROD</i>	<i>171 42 00</i>	<i>11.518</i>	<i>0.243</i>
<i>HEXAGONAL ROD</i>	<i>58 16 20</i>	<i>7.179</i>	<i>0.187</i>	<i>STAR PICKET (2)</i>	<i>189 55 30</i>	<i>4.735</i>	<i>0.056</i>
<i>DARLING (P)</i>	<i>285 58 10</i>			<i>DARLING (P)</i>	<i>287 27 40</i>		

STANDPOINT: *HEXAGONAL ROD G.P.S. MARK*

STANDPOINT: *STAR PICKET (1)*

Prepared by: *P.BETS 31/7/90*

Checked: *S. Paul 2/8/90*

Noted on U.I.M. Card

Checked

GS 24

512735-2 G. West Government Profile Beacon Diagram:	Not to Scale	STATION <u>ROUND GI PILLAR TS 3960</u>
Owner's Name <u>MINING LEASE</u> Address <u>PREMIACO MINING CO</u> <u>BROKEN HILL</u> Phone <u>080 888529</u> Access Report of <u>19</u> was found suitable/unsuitable.		Current Occupant: Address: Phone:
This section to be completed by officer constructing pillar. Original station mark found/not found. Description of mark: Original beacon found/not found. Description of beacon: Height Top of Vanes to Top Markm. Height of markm. above G.L. below Diameter of Vanesm. Height of Cairnm. Original Beacon has/has not been destroyed by me.		Record of Station Date

GEODETTIC STATION RECONNAISSANCE and MAINTENANCE REPORT


STATION: ROUND GS No.: 3960

MAP SHEETS SCALE 1:250 000 No.: 100 000
 TACTON GAV

INSPECTED BY: P.B.TS DATE: 17/7/90

AUTHORITY: LAND INFORMATION CENTRE FIELD BOOK: CG05

Station Diagram

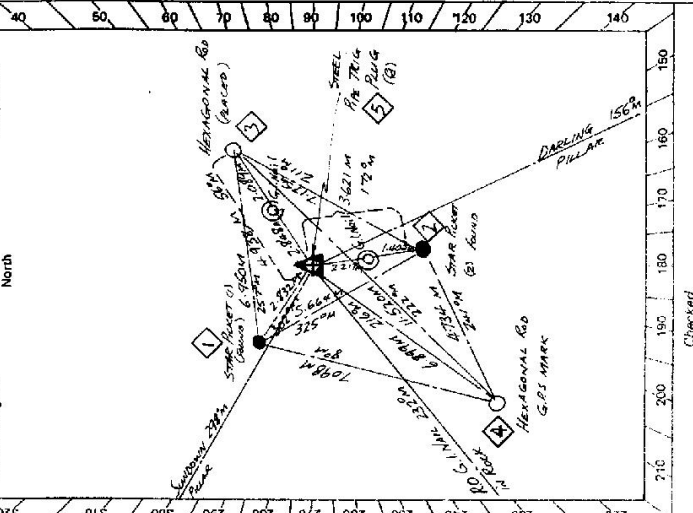

Description:	STANDPOINT: STEEL PIPE TRIG PUGS				STANDPOINT: HEXAGONAL ROAD			
	Mark	Direction	Horiz. Distance	Height Difference	Mark	Direction	Horiz. Distance	Height Difference
1. Cleared by lanes bearing <u>366.04</u> ✓ Note: <u>Cross out word or words which do not apply</u> from Trig. Mast								
2. Mast & Vanes have been painted white & black respectively.								
3. The station/pillar was unpiled/not unpiled/constructed on <u>1.74</u> <u>Soil</u> <u>19.90</u> m., dimensions now being:								
Description of mark: <u>STEEL PIPE</u> should be explicit, e.g., S/Steel Pillar Plate, Steel plug, Brass plug, Bolt, G.I. Pipe								
Height of mark: <u>0.775</u> m. above <u>concrete</u> Mark is <u>0.775</u> m. above G.L.								
Height of Top Vanes to Top Mark: <u>1.265</u> m. Diameter of Vanes (vertical): <u>0.300</u> m.								
Height of Cairn: <u>0.00</u> m. Diameter of Cairn: <u>0.00</u> m. Name Plate found/not found/placed.								
Length of Mast: <u>0.00</u> m. (approximate if not unpiled) <u>OVERHEAD TRIP/POD</u>								
4. A <u>STAR PILETT (1)</u> set in <u>concrete/rock</u> has been <u>placed</u> /found, bearing <u>302.0</u> °M from <u>Mast/Plug/Pillar</u>								
5. A <u>STAR PILETT (2)</u> set in <u>concrete/rock</u> has been <u>placed</u> /found, bearing <u>276.0</u> °M from <u>Mast/Plug/Pillar</u>								
6. A <u>STAR PILETT (1)</u> set in <u>concrete/rock</u> has been <u>placed</u> /found, bearing <u>171.0</u> °M from <u>Mast/Plug/Pillar</u>								
7. A <u>STAR PILETT (2)</u> set in <u>concrete/rock</u> has been <u>placed</u> /found, bearing <u>56.0</u> °M from <u>Mast/Plug/Pillar</u>								
8. Action required:								

Prepared by: P.B.TS 31/7/90
 Checked: P.B.TS 2/8/90
 Named on U.T.M. Card

Not to Scale
 North
 Station Diagram
 330 340 350 360 370 380 390 400
 220 230 240 250 260 270 280 290 300 310 320
 140 150 160 170 180 190 200 210 220
 270 280 290 300 310 320 330 340 350 360 370 380 390 400
 710 720 730 740 750 760 770 780 790 800 810 820 830 840 850 860 870 880 890 900

GS 24

<p>STATION <u>Round GS</u> TS <u>3960</u></p> <p>Owner's Name <u>Maxing Lease</u> Address <u>Praxingo Mining Co.</u> Phone <u>080 88829</u> Access Report of <u>19</u> was found suitable/unsuitable.</p> <p>Current Occupant: Address: Phone:</p>	<p>Beacon Diagram</p> <p style="text-align: right;">Nmt to Scale</p>
<p>This section to be completed by officer constructing pillar.</p> <p>Original station mark found/not found.</p> <p>Description of mark: <u>Steel Pipe in Concrete</u></p> <p>Original beacon found/not found.</p> <p>Description of beacon: <u>Steel Tripod</u></p> <p>Height Top of Vanes to Top Mark <u>1.865</u> m. above G.L.</p> <p>Height of mark <u>0.755</u> m. above mark/conc below</p> <p>Diameter of Vanes <u>0.300</u> m. Height of Cairn <u>N/A</u> m.</p> <p>Original Beacon has/was been destroyed by ma.</p>	
	<p>Date</p> <p>Record of Station</p>

Page 2 of 2

GEODETTIC SURVEY OF N.S.W.

CENTRAL MAPPING AUTHORITY


GEODETTIC STATION RECONNAISSANCE and MAINTENANCE REPORT

STATION: *Round GS* No: *3960*

MAP SHEETS SCALE 1:250 000 *TARANGAN*

INSPECTED BY: *P.Bans* DATE: *17/1/90*

AUTHORITY: *Land Information Centre* FIELD BOOK: *C605*

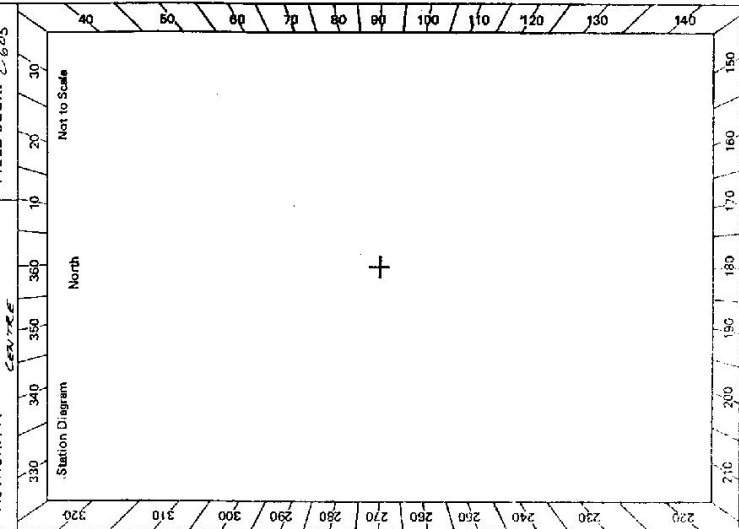

- Description: *Note: Cross out word or words which do not apply*
- Cleared by lanes bearing..... from Trig. Mast
 - Mast & Vanes have been painted white & black respectively.
 - The station/pillar was unpiled/not unpiled/constructed on..... dimensions now being:
 - Description of mark..... should be explicit, e.g., S/Steel Pillar Plate, Steel plug, Brass plug, Bolt, G.I. Pipe
 - Height of mark..... m. ^{above}/_{below} rock/concrete; Mark is..... m. ^{above}/_{below} G.L.
 - Height of Top Vanes to Top Mark/Pillar plate..... m. Diameter of Vanes (vertical)..... m.
 - Height of Cairn..... m. Diameter of Cairn..... m. Name Plate found/not found/placed.
 - Length of Mast..... m. (approximate if not unpiled)
 - A..... set in conc/rock has been placed/found, bearing..... °M from Mast/Plug/Pillar
 - A..... set in conc/rock has been placed/found, bearing..... °M from Mast/Plug/Pillar
 - A..... set in conc/rock has been placed/found, bearing..... °M from Mast/Plug/Pillar
 - A..... set in conc/rock has been placed/found, bearing..... °M from Mast/Plug/Pillar

STANDPOINT: *STAR PICKET (2)* *HEXAGONAL ROD G.P.S. MARK*

Mark	Direction	Horiz. Distance	Height Difference	Mark	Direction	Horiz. Distance	Height Difference
<i>RO NAIL IN BOX</i>	<i>0 00 00</i>	<i>0 00 00</i>	<i>0 055</i> ^{above} / _{below} <i>standpt.</i>	<i>RO NAIL IN BOX</i>	<i>0 00 00</i>	<i>0 00 00</i>	<i>0 055</i> ^{above} / _{below} <i>standpt.</i>
<i>HEXAGONAL ROD (2)</i>	<i>0 25 10</i>	<i>4 735</i>	<i>0 055</i> ^{above} / _{below} <i>standpt.</i>	<i>SUNDOWN (P)</i>	<i>61 50 30</i>	<i>0 165</i> ^{above} / _{below} <i>standpt.</i>	<i>0 165</i> ^{above} / _{below} <i>standpt.</i>
<i>SUNDOWN (P)</i>	<i>60 17 30</i>	<i>5 644</i>	<i>0 162</i> ^{above} / _{below} <i>standpt.</i>	<i>STAR PICKET (1)</i>	<i>137 12 25</i>	<i>7 098</i>	<i>0 165</i> ^{above} / _{below} <i>standpt.</i>
<i>STAR PICKET (1)</i>	<i>93 58 50</i>	<i>1 403</i>	<i>0 211</i> ^{above} / _{below} <i>standpt.</i>	<i>STEEL PIPE TRIG. ROD</i>	<i>160 30 20</i>	<i>6 899</i>	<i>1 254</i> ^{above} / _{below} <i>standpt.</i>
<i>RO NAIL</i>	<i>119 00 30</i>	<i>1 403</i>	<i>0 211</i> ^{above} / _{below} <i>standpt.</i>	<i>HEXAGONAL ROD</i>	<i>171 42 00</i>	<i>11 512</i>	<i>0 243</i> ^{above} / _{below} <i>standpt.</i>
<i>STEEL PIPE TRIG. ROD</i>	<i>119 00 30</i>	<i>3 621</i>	<i>1 197</i> ^{above} / _{below} <i>standpt.</i>	<i>STAR PICKET (2)</i>	<i>189 55 45</i>	<i>4 734</i>	<i>0 085</i> ^{above} / _{below} <i>standpt.</i>
<i>HEXAGONAL ROD</i>	<i>68 15 45</i>	<i>7 126</i>	<i>0 187</i> ^{above} / _{below} <i>standpt.</i>	<i>DAQUINE (P)</i>	<i>287 28 00</i>	<i>0 000</i>	<i>0 000</i> ^{above} / _{below} <i>standpt.</i>
<i>DAQUINE (P)</i>	<i>285 58 15</i>	<i>0 000</i>	<i>0 000</i> ^{above} / _{below} <i>standpt.</i>				

Prepared by: *P.Bans* 31/7/90 Checked: *P.Bans* 2/8/90 Named on U.T.M. Card

LAND INFORMATION CENTRE

GEODETIC SURVEY OF A.S.M.

GEODETIC STATION RECONNAISSANCE and MAINTENANCE REPORT

STATION: **Round.** No.: **3960**

MAP SHEET SCALE 1:250,000 **BROKEN HILL**

INSPECTED BY: **FREIGHT TRAIL** DATE: **MAY '94**


AUTHORITY: FIELD BOOK:

Description: *Note: Cross out word or words which do not apply*

1. Cleared by lanes bearing..... from Trig. Mast
2. Mast & Vanes have been painted white & black respectively.
3. The station/pillar was unpiled/not unpiled/constructed on..... 19..... dimensions now being:
Description of mark..... should be explicit, e.g., S/Steel Pillar Plate, Steel plug, Brass plug, Bolt, G.I. Pipe
Height of mark.....^{above} rock/concrete; Mark is.....^{above}.....^{below}.....m. G.L.
Height of Top Vanes to Top Mark/Pillar platem. Diameter of Vanes (vertical).....m.
Height of Cairn.....m. Diameter of Cairn.....m. Name Plate found/not found/placed.
Length of Mastm. (approximate if not unpiled)
4. A.....set in conc/rock has been placed/found; bearing.....°M from Mast/Plug/Pillar
5. A.....set in conc/rock has been placed/found; bearing.....°M from Mast/Plug/Pillar
6. A.....set in conc/rock has been placed/found; bearing.....°M from Mast/Plug/Pillar
7. A.....set in conc/rock has been placed/found; bearing.....°M from Mast/Plug/Pillar

8. Action required:.....


STANDPOINT:			
Mark	Direction	Horiz. Distance	Height Difference
			above standpt.
			below
			above standpt.
			below
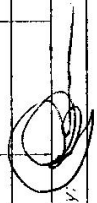Prepared by:  16/94

Checked: *[Signature]*

Noted on U.T.M. Card

Checked

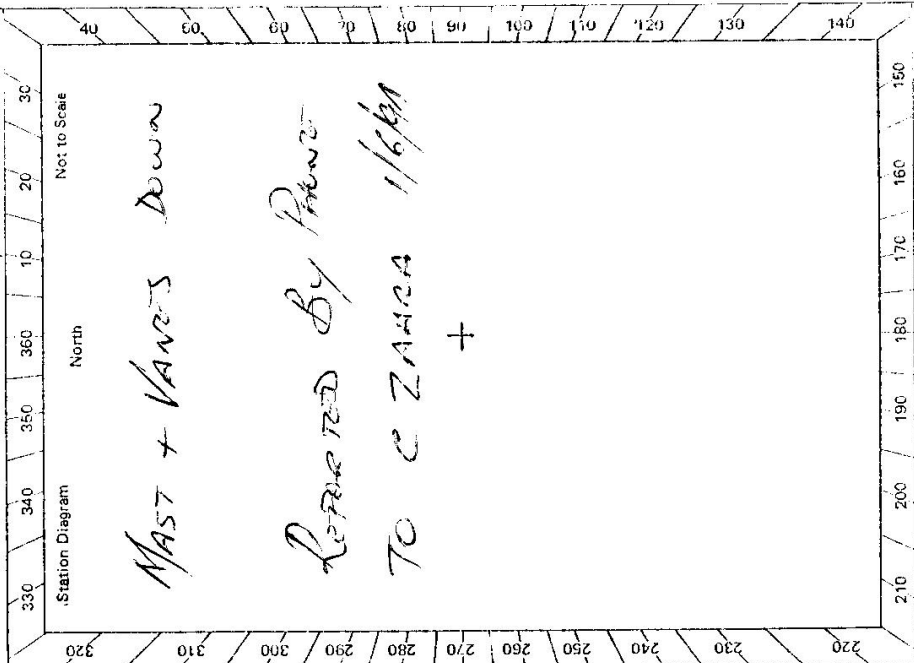

GS 24

STATION ROUND G.S. PILLAR TS 3960

Owner's Name: MINING LEASE
 Address: BROKEN HILL
 Phone: 080 888529

Current Occupant:
 Address:
 Phone:


ACCESS:

Access Report of 21.7.1980 was found suitable/unavailable.

K.M FEATURE 4M.D
800 1ST OFFICE BROKEN HILL TRAVEL NORTH ALONG ARGENT STREET
TOWARDS WILCANNIA BARRIER HIGHWAY
4.85 TURN LEFT OFF BARRIER HIGHWAY JUST AFTER MULLGA CREEK
5.74 TURN RIGHT ONTO TRACK, FOLLOW THIS TRACK UP STEEP SLOPE TO TRIG
6.16 PASS TRACK ON RIGHT
6.45 ROUND G.S. PILLAR

2733-2 C. West Government Printer
 Beacon Diagram

Not to Scale

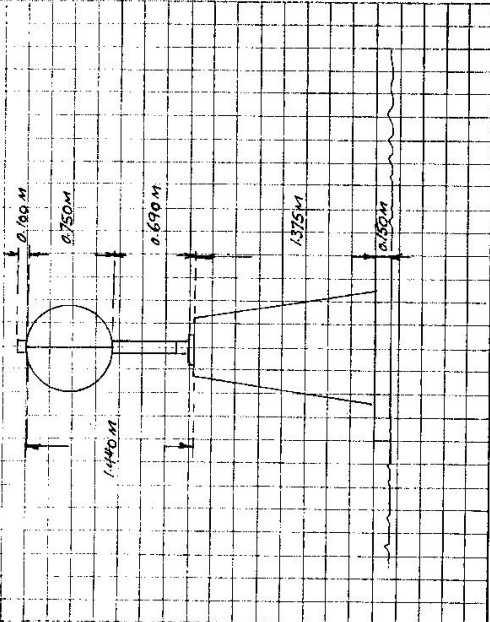

This section to be completed by officer constructing pillar.

Original station mark found/~~was~~ found.

Description of mark: STEEL PIPE TRIG PILE

Original beacon found/~~was~~ found.

Description of beacon: STEEL TRIPILE

Height Top of Vanes to Top Mark: 1.865 m.

Height of mark: 0.375 m. above rock/conc. below G.L.

Diameter of Vanes: 0.280 m. Height of Cairn: NA m.

Original Beacon has/~~was~~ not been destroyed by me.

Date	Record of Station