

CENTRAL MAPPING AUTHORITY

Department of Lands

Trigonometrical Survey of N.S.W.

RECONNAISSANCE and MAINTENANCE REPORT

This Trig. Station has been:-

Note: Cross out word or words which do not apply

1. Completely ~~cleared to permit~~ ^{improved back-up} 360° vision to surrounding Trigs.
2. Cleared by lanes bearing _____ from Trig. Mast
3. Trig-Mast & Vanes have been painted white & black respectively.
4. The Trig. was ~~emptied~~ not unpiled, dimensions now being: _____

Description of mark _____ should be explicit, e.g. Steel plug, Brass plug, Bolt, G.L. Pipe

Height of mark _____ m above rock/concrete _____ m below G.L.

Height of Top Vanes to Top Mark _____ m. Diameter of Vanes (vertical) 0.76 m.

Height of Cairn 1.40 m. Diameter of Cairn 1.20 m.

Length of Mast 3.46 m. (approximate if not unpiled)

5. A set in conc/rock has been placed _____ m. bearing _____°M from Trig. Mast
6. A set in conc/soil has been placed _____ m. bearing _____°M from Trig. Mast
7. A set in conc/soil has been placed _____ m. bearing _____°M from Trig. Mast
8. A set in conc/rock has been placed _____ m. bearing _____°M from Trig. Mast

9. Connection to _____ m. bearing _____°M

10. Connection to _____ m. bearing _____°M

11. Connection to _____ m. bearing _____°M

12. Connection to _____ m. bearing _____°M

13. Diff. Ht. _____ is _____ m. above _____ below

14. Diff. Ht. _____ is _____ m. above _____ below

15. Diff. Ht. _____ is _____ m. above _____ below

16. Diff. Ht. _____ is _____ m. above _____ below

Prepared by: M.L. Morrison

Checked:

Noted on U.T.M. Card

STATION ROUND HILL TS 3964


Co: VERARON Ph: KANGAROO FLAT

Map Sheet: COWARRAL No: 9335

Inspected by: M.L. MORRISON Date: 16th August 1977

Authority: _____ Field Book: 1581

Beacon Diagram Not to Scale

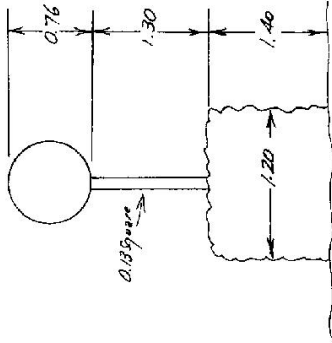

Date _____ Record of Station

TRIG. SET IN GOOD ORDER. NEEDS PAINTING
NO OTHER OBJECTS NOT REMOVABLE TO CLEAR TOP
OF HILL BUT EASY TO LOCATE. NOT 2nd class Pt. Line.

Checked

