

7-5-10-3

Department of Lands

Integrated Survey of N.S.W.

RECONNAISSANCE and MAINTENANCE REPORT

This Trig. Station has been:-

Note: Cross out word or words which do not apply

1. Completely cleared to permit 360° vision to surrounding Trigs. ✓
2. ~~Cleared by lens-bearing~~
3. ~~Trig. Mast & Vane have been painted white & black respectively~~
4. ~~The Trig. was unpiled/not unpiled, dimensions now being:~~

Description of mark Brass Screw in Lead Roof should be explicit, e.g. Steel plug, Brass plug, Bolt, Concrete Pillar

Height of mark 0.1 m above rock/concrete 0.1 m above 6.1 below

Height of Top Vane to Top Mark/Top pillar plate 0.1 m Diameter of Vane (vertical) 0.1 m.

Height of Coin 0.1 m Diameter of Coin 0.1 m.

- Length of Mast Lead Roof m (approximate if not unpiled)
5. A. New Cross set in concrete has been placed/td 10.035 m. bearing 10.0°M from Trig. Lead Roof
  6. A. Lead set in concrete has been placed/td 2.061 m. bearing 3.2°M from Trig. Lead Roof
  7. A. Lead set in conc./soil has been placed/td 0.1 m. bearing 0.1°M from Trig. Mast/pillar
  8. A. Lead set in conc./rock has been placed/td 0.1 m. bearing 0.1°M from Trig. Mast/pillar
  9. Connection: Screw to New Cross : 1.298 m. bearing 23.5°M

10. Connection: to to : 0.1 m. bearing 0.1°M
11. Connection: to to : 0.1 m. bearing 0.1°M
12. Connection: to to : 0.1 m. bearing 0.1°M
13. Diff. Ht. Screw (15) is 0.00 m. above below Screw 2 Level.
14. Diff. Ht. is 0.1 m. above below
15. Diff. Ht. is 0.1 m. above below
16. Diff. Ht. is 0.1 m. above below

Prepared by: [Signature] Checked: [Signature]

STATION TS 3989 RYDE

Co: COMBERLAND Pli: HONTERS HU.

Map Sheet: Gladesville 0952 No:

Inspected by: H.G. Heston Date: 16 Jan 1979

Authority: INTEGRATION SURVEYS Field Book: 127A/03  
BRAND.

Beacon Diagram Not to Scale

**NO TRIG BEACON ERECTED**

**CO-ORDINATES OF NEW CROSS**

**AVE 309 550 436 1256 827.496**

**Zone 59/1.**

**Calculated & Checked.**

Date

Record of Station

STATION **TS 3989 Ryde.**


Owners Name.....  
 Address.....  
 Current Occupant.....  
 Address.....

Access  
**16-1-1979**

Obtain key to Church from Vicars residence next door in (Church Street).  
 Entry is from Vestry, Then proceed to front of Church (Main entrance) and climb to roof of tower. (1 staircase & 3 ladders).

Note: CARE SHOULD BE TAKEN NOT TO BUMP CLOCK MOVEMENTS OR BELL ROPES

D. West, Government Printer, New South Wales - 1976

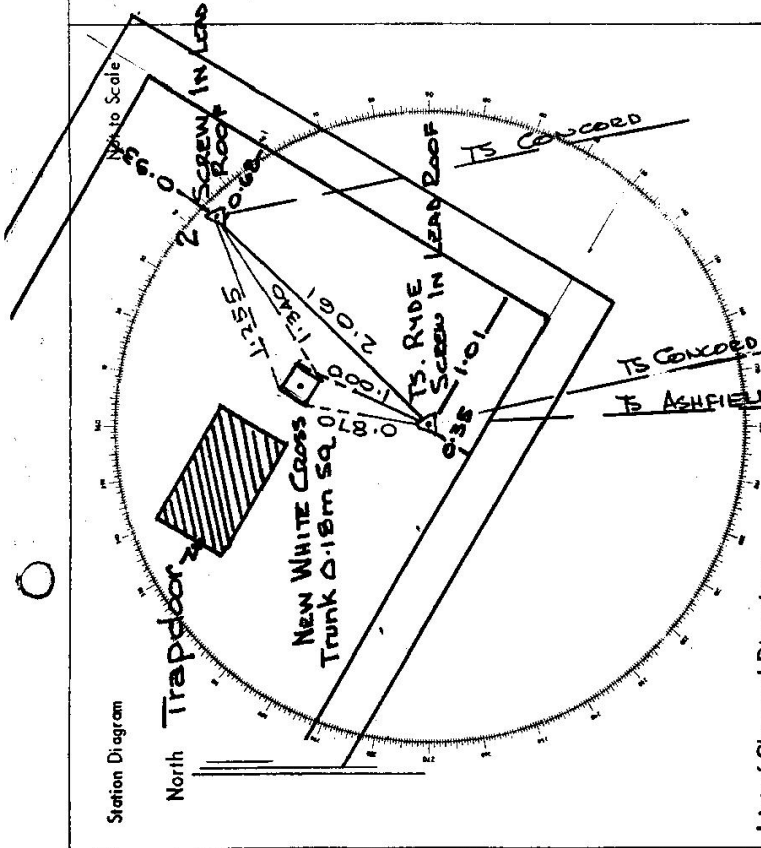

List of Observed Directions:-

Station	Direction	Station	Direction
TS 1500 CONCORD	157.00 00	TS 1500 CONCORD	60 03 00
TS CONCORD	157.55 315	TS 3989 RYDE	115 44 57
CROSS LHS	0 25 50	CROSS RHS	129 01 18
CROSS RHS	13 00 22	Screws In Roof 2	139 02 30
Screws In Roof 2	32 43 52		

Station	Direction	Station	Direction