

CENTRAL MAPPING AUTHORITY

GEODETIC SURVEY OF N.S.W.

GEODETIC STATION RECONNAISSANCE and MAINTENANCE REPORT

STATION: **RYRIE GS** No: **3992**
 MAP SHEET SCALE: **1:250 000** **CANBERRA**
 INSPECTED BY: **W MILLER** DATE: **1.2.79**
 AUTHORITY: **CMA** FIELD BOOK:

- Description:
 Note: Cross out word or words which do not apply
1. Cleared by lanes bearing..... **360°** **S. 10.0m** **small** **from Trig. Mast**
 2. Mast & Vanes have been painted white & black respectively.
 3. The station/~~pillar~~ was ~~unpiled~~/not unpiled/~~conspicuous~~ on..... **1.2** **1979** dimensions now being:
 Description of mark..... should be explicit, e.g., S/Steel Pillar Plate, Steel plug, Brass plug, Bolt, G.I. Pipe
 Height of mark..... ^{above} **1.5** m. _{below} rock/concrete; Mark is..... ^{above} m. _{below} G.L.
 Height of Top Vanes to Top Mark/Pillar plate m. Diameter of Vanes (vertical)..... m.
 Height of Cairn..... **1.5** m. Diameter of Cairn..... **3** m. Name Plate found/not found/placed.
 Length of Mast..... **3.2** m. (approximate if not unpiled)
 4. A..... ^{above} set in conc./rock has been placed/found, bearing..... ° M from Mast/Plug/Pillar
 5. A..... ^{above} set in conc./rock has been placed/found, bearing..... ° M from Mast/Plug/Pillar
 6. A..... ^{above} set in conc./rock has been placed/found, bearing..... ° M from Mast/Plug/Pillar
 7. A..... ^{above} set in conc./rock has been placed/found, bearing..... ° M from Mast/Plug/Pillar
 8. Action required:.....

STANDPOINT:

Mark	Direction	Horiz. Distance	Height Difference	Mark	Direction	Horiz. Distance	Height Difference
			above standpt.				above standpt.
			below				below
			above standpt.				above standpt.
			below				below
Prepared by: **W Miller** Checked: **26.2.79** Noted on U.T.M. Card

Sr 2733-2 D. West. Government Printer

Beacon Diagram

Not to Scale

Vanes Damaged

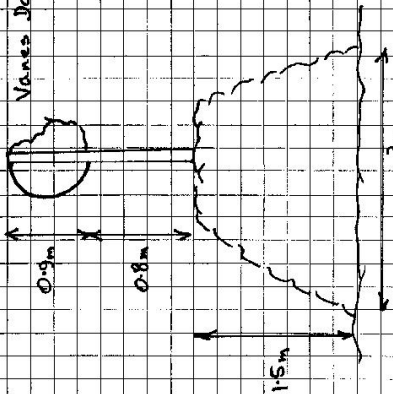

This section to be completed by officer constructing pillar.

Original station mark found/not found.

Description of mark:

Original beacon found/not found.

Description of beacon:

Height Top of Vanes to Top Mark.....m.

Height of mark.....m. above rock/conc.....m. below G.L.


Diameter of Vanes.....m. Height of Cairn.....m.

Original Beacon has/has not been destroyed by me.

STATION RYRIE GS TS 3992

Owner's Name:
 Address:
 Phone:
 Current Occupant:
 Address:
 Phone:

ACCESS
 Access Report of 1.1.1979 was found suitable/unsuitable.

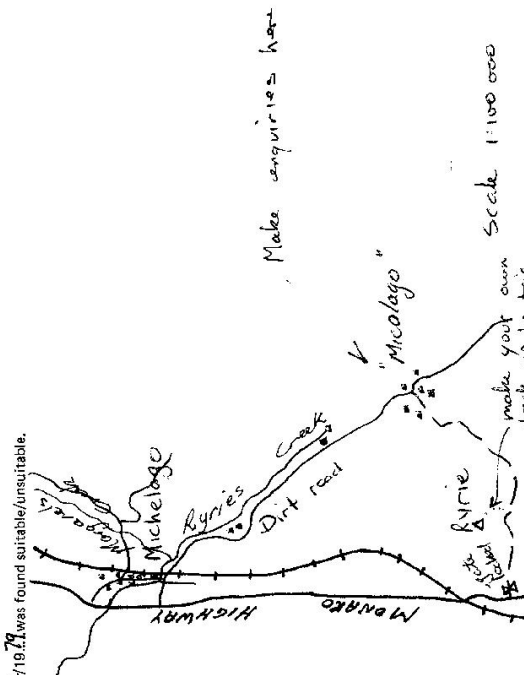

Date

1.2.79

V. J. T. C.

Record of Station