

74-98


STATION SMA 1015
TS 4

Co: *Salween* Pk: *Table Top*
Map Sheet: *Yarranggabully* No: *6526*

Inspected by: *M.D. Benge* Date: *24th February 1977*

Authority: *Central Mapping* Field Book: *Electronically 87165*

Beacon Diagram Not to Scale

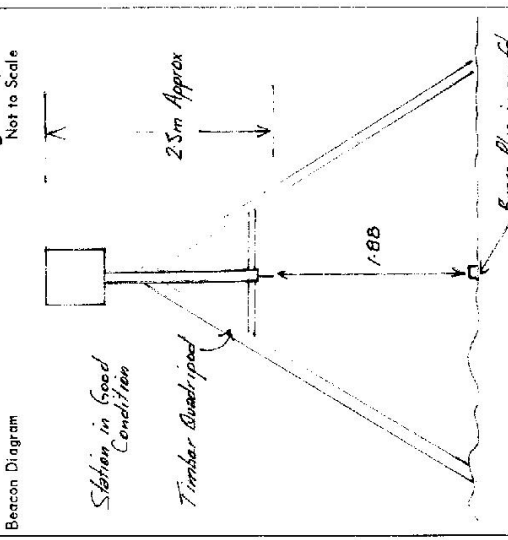

Record of Station

| Date | Checked |
|------|---------|
| | |
| | |
This Trig. Station has been:- *Note: Cross out word or words which do not apply*

1. Completely cleared to permit 360° vision to surrounding Trigs.
2. Cleared by lanes-bearing..... from Trig. Mast-
3. Trig. Mast & Vanes have been painted white & black respectively. *Needs painting*
4. The Trig. was unpiled/not unpiled, dimensions now being:.....

Description of mark *S.M. Brass Plug in Conc.* should be explicit, e.g. Steel plug, Brass plug, Bolt, G.I. Pipe
 Height of mark..... m above rock/concrete..... m above G.L.
 Height of Top Vanes to Top Mark..... m. Diameter of Vanes (vertical)..... m.

Height of Cairn..... m. Diameter of Cairn..... m.

Length of Mast..... m. (approximate if not unpiled)

5. A..... set in conc/rock has been placed..... m. bearing.....°M from Trig. Mast
6. A..... set in conc/soil has been placed..... m. bearing.....°M from Trig. Mast
7. A..... set in conc/soil has been placed..... m. bearing.....°M from Trig. Mast
8. A..... set in conc/rock has been placed..... m. bearing.....°M from Trig. Mast

9. Connection..... to *tip*..... m. bearing.....°M
10. Connection..... to *tip*..... m. bearing.....°M
11. Connection..... to *No*..... m. bearing.....°M
12. Connection..... to *No*..... m. bearing.....°M
13. Diff. Ht. is..... m. above below
14. Diff. Ht. is..... m. above below
15. Diff. Ht. is..... m. above below
16. Diff. Ht. is..... m. above below

Prepared by: *N. Benge* Checked: *[Signature]* 13/1/77 Noted on U.T.M. Card

